


**E1** LEVEL 1 - LIFE SAFETY FLOOR PLAN (PHASE 1 EGRESS PLAN FOR EXISTING NEURO/CARDIO OUTPATIENT DEPARTMENT)  
SCALE: 1/16" = 1'-0"

**E4** PARTIAL FLOOR PLAN - LEVEL 1 - LIFE SAFETY FLOOR PLAN (PHASE 2 EGRESS PLAN FOR EXISTING NEURO/CARDIO DEPARTMENT)  
SCALE: 1/16" = 1'-0"

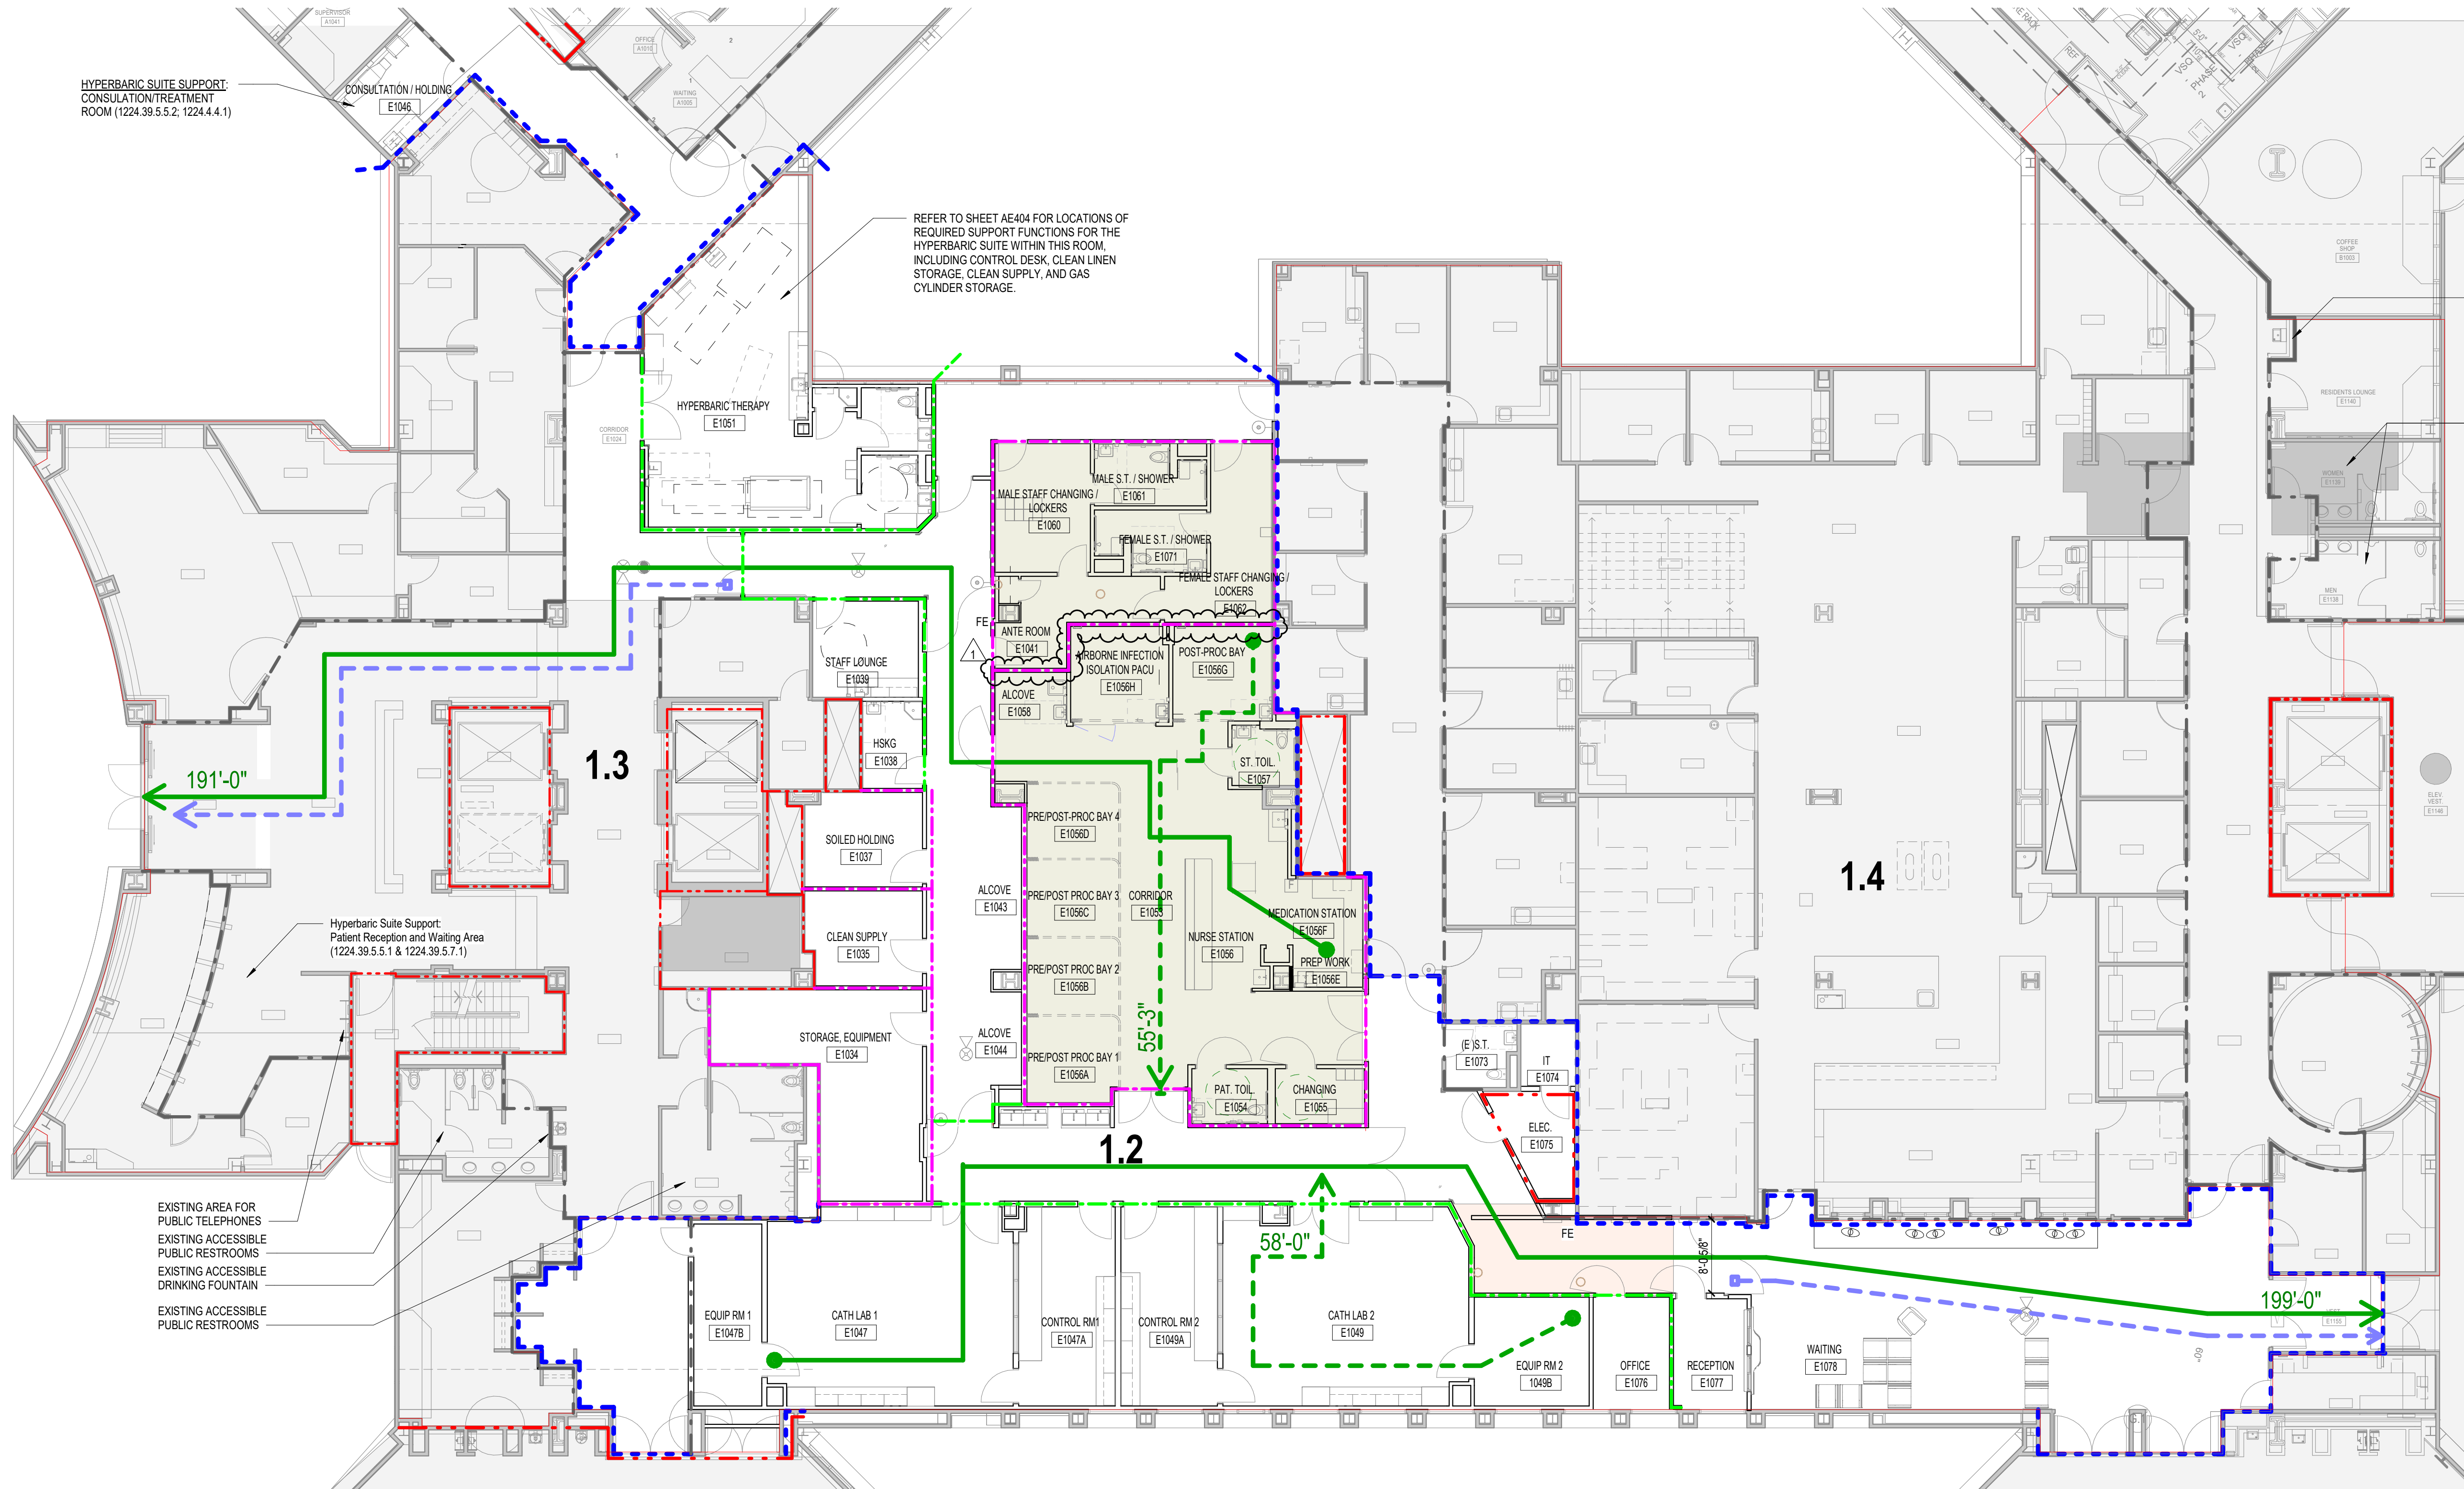

**A1** LEVEL 1 - LIFE SAFETY FLOOR PLAN (FOR NEW CATH LAB DEPARTMENT)  
SCALE: 1" = 10'-0"

**LIFE SAFETY GENERAL NOTES**

- ALL FIRE RATED PARTITIONS ARE EXISTING AND WITHIN THE CORE AREA, PATCH TO MAINTAIN RATING IF DISTURBED.
- WOOD USED FOR BLOCKING, NAILERS, OR FRAMING IN FIRE RATED ASSEMBLIES SHALL BE FIRE RETARDANT TREATED. REFER TO SPECIFICATION SECTION 08 10.03 FOR EXIST LIGHTS AND EMERGENCY LIGHTING. SEE ELECTRICAL.
- FOR FIRE DETECTION SYSTEM, SEE ELECTRICAL.
- FOR FIRE ALARM SYSTEM, SEE ELECTRICAL.
- WHERE FIRE EXTINGUISHER CABINETS OR OTHER EQUIPMENT IS RECESSED IN FIRE RATED PARTITIONS, MODIFY THE PARTITION AS REQUIRED TO PROVIDE A CONTINUOUS ENCLOSURE TO ENSURE UNINTERRUPTED FIRE RATING.
- AT EXISTING FIRE RATED DOOR LOCATIONS FRAMES SHALL BE NEW AND DOORS SHALL BE LABELED FOR THE INTENDED USE OR EQUIVALENT.
- NON-RATED SMOKE PARTITIONS SHALL BE CONSTRUCTED TO LIMIT THE TRANSFER OF SMOKE. PARTITIONS SHALL EXTEND FROM FLOOR SLAB TO UNDERSIDE THE DECK ABOVE. THE SPACE ADJACENT TO THE DECK AND OTHER SURFACES AND THE SPACES AROUND PENETRATING ITEMS SHALL BE CAULKED TO LIMIT THE FREE PASSAGE OF SMOKE.
- HYPHERBARIC CHAMBERS FOR HUMAN OCCUPANCY AND THEIR SUPPORTING SYSTEMS SHALL BE DESIGNED AND FABRICATED TO MEET ANSI/ASME PVHO-1, SAFETY STANDARD FOR PRESSURE VESSELS FOR HUMAN OCCUPANCY, BY PERSONNEL QUALIFIED TO FABRICATE VESSELS UNDER SUCH CODES PER 2021 NFPA 99, SECTION 14.2.2.1.

**CODE ANALYSIS LEGEND**

REFER TO SHEET AE511 FOR DETAILS AND LISTINGS FOR CONSTRUCTION OF RATED PARTITIONS AND BARRIERS

- FP** 1 HOUR FIRE PARTITION PER CBC SECTION 708. OPENINGS FIRE RATED FOR 20 MINUTES FOR CORRIDOR PARTITIONS AND 45 MINUTES FOR OTHER FIRE PARTITIONS.
- FB** 1 HOUR FIRE BARRIER PER CBC SECTION 706. OPENINGS FIRE RATED FOR 60 MINUTES FOR SHIFTS, EXIT STAIRWAYS AND EXIT PASSAGEWAY WALLS AND 45 FOR OTHER FIRE BARRIERS.
- FB** 2 HOUR FIRE BARRIER PER CBC SECTION 706. OPENINGS FIRE RATED FOR 90 MINUTES.
- SP** SMOKE PARTITION PER CBC SECTION 710. OPENINGS TO BE RELATIVELY TIGHT FITTING AS REQUIRED TO RESIST PASSAGE OF SMOKE.
- SB** 1HR SMOKE BARRIER PER CBC SECTION 708. OPENINGS TO BE RELATIVELY TIGHT FITTING AS REQUIRED TO RESIST PASSAGE OF SMOKE.
- EXISTING 1 HOUR FIRE PARTITION PER CBC SECTION 708. OPENINGS FIRE RATED FOR 20 MINUTES FOR CORRIDOR PARTITIONS AND 45 MINUTES FOR OTHER FIRE PARTITIONS.
- TRAVEL DISTANCE
- ROOM (NET) AND AREA (GROSS) TAGS INDICATING SQUARE FOOTAGE, OCCUPANCY, LOAD FACTOR, AND RESULTING OCCUPANCY BELOW
- INDICATES NUMBER OF OCCUPANTS EXITING ON EGRESS PATH
- ACCESSIBLE PATH OF TRAVEL TO BUILDING ENTRANCE
- EGRESS PATH WITH NAME, SEGMENT LENGTH, AND DIRECTION INDICATED
- EXIT INDICATOR BASIC: WITH NAME OF EXIT AND TOTAL OCCUPANTS EXITING INDICATED
- EXIT INDICATOR ADVANCED: WITH NAME OF EXIT, TOTAL OCCUPANTS EXITING INDICATED, SIZE OF OPENING VS ACTUAL OPENINGS WIDTH
- OCCUPANCY GROUP
- PATIENT CARE NON-SLEEPING SUITE
- EXISTING AREA TO REMAIN, AREA NOT IN SCOPE OF WORK
- 1 HOUR CEILING AREA

1ST FLOOR - EXISTING HEALTHCARE OCCUPANCY						
COMPARTMENT ID	COMPARTMENT SQ. FT.	OCCUPANCY LOAD	SPRINKLER SYSTEM	AREA USE	DISTANCE SMOKE	DISTANCE EXIT
1.1	8,603	36	FULL	TREATMENT	66'	105'
1.2	5,125	44	FULL	TREATMENT	86'	204'
1.3	12,538	129	FULL	TREATMENT	57'	194'
1.4	11,150	116	FULL	TREATMENT	107'	146'
1.5	10,459	105	FULL	TREATMENT	159'	78'

2022 CBC CODE APPLICATION MATRIX					
Room #	Room Name	Room Function	App'l Code Ref.	SF Req'd	SF Provided
E1034	STORAGE, EQUIPMENT		1224.16.5.5		361 SF
E1035	CLEAN SUPPLY		1224.28.2.7		136 SF
E1037	SOILED HOLDING		1224.28.2.8		138 SF
E1038	HOUSEKEEPING		1224.28.2.9	15 SF	70 SF
E1039	STAFF LOUNGE				134 SF
E1040	CORRIDOR		1224.4.7		41 SF
E1041	ANTE ROOM				
E1043	ALCOVE		1224.4.7		
E1044	ALCOVE		1224.28.2; 1224.28.2.1	400 SF	565 SF
E1046	CORRIDOR		1224.28.2.3		147 SF
E1047	CATH LAB 1		1224.28.2.2		226 SF
E1049	EQUIP RM 1		1224.28.2.2		229 SF
E1050	CONTROL RM 2		1224.28.2.2		565 SF
E1051	CATH LAB 2		1224.28.2; 1224.28.2.1	400 SF	565 SF
E1052	EQUIP RM 2		1224.28.2.3		148 SF
E1051	HYPERBARIC THERAPY		1224.39.5; 1224.39.5.2.2		648 SF
E1051A	STAFF TOILET		1224.39.5.6		41 SF
E1051B	PATIENT TOILET / CHANGING		1224.39.5.7.2; 1224.39.5.7.3		71 SF
E1051C	HOUSEKEEPING		1224.39.5.7		24 SF
E1053	CORRIDOR		1224.39.5.7		
E1054	PATIENT TOILET		1224.4.4.8		49 SF
E1055	CHANGING ROOM		1224.16.7.2		54 SF
E1056	NURSE STATION		1224.16.5.1;		162 SF
E1056A	PRE/POST PROC BAY 1		1224.28.2.6; 1224.16.2	80 SF	82 SF
E1056B	PRE/POST PROC BAY 2		1224.28.2.6; 1224.16.2	80 SF	83 SF
E1056C	PRE/POST PROC BAY 3		1224.28.2.6; 1224.16.2	80 SF	83 SF
E1056D	PRE/POST PROC BAY 4		1224.28.2.6; 1224.16.2	80 SF	83 SF
E1056E	PREP WORK AREA				57 SF
E1056F	MEDICATION STATION		1224.16.5.3		63 SF
E1056G	POST-PROCEDURE BAY		1224.28.2.6; 1224.16.3		115 SF
E1056H	AIRBORN INFECTION ISOLATION EXAM/TREATMENT		1224.28.2.6; 1224.4.4.1.3		111 SF
E1057	STAFF TOILET		1224.16.6		45 SF
E1058	ALCOVE				
E1059	CORRIDOR		1224.4.7.2		
E1060	MALE STAFF CHANGING / LOCKERS		1224.28.2.5		138 SF
E1061	MALE STAFF TOILET / SHOWER				75 SF
E1062	FEMALE STAFF CHANGING / LOCKERS		1224.28.2.5		162 SF
E1071	FEMALE STAFF TOILET / SHOWER		1224.4.4.8		75 SF
E1073	STAFF TOILET		1224.4.4.8		49 SF
E1074	IT ROOM		1224.5.2		41 SF
E1075	ELECTRICAL				79 SF
E1076	OFFICE		1224.21.1		98 SF
E1077	RECEPTION				98 SF
E1078	WAITING		1224.16.7.1; 1224.4.5		
A1048	HYPERBARIC PATIENT COUNSELING		1224.39.5.5.2; 1224.4.4.1	80 SF	
E1080	(E) PATIENT ADVOCACY				
E1107	HOLDING - GURNEY				

**RIVERSIDE UNIVERSITY HEALTH SYSTEM**  
MEDICAL CENTER  
26520 CACTUS AVENUE, MORENO VALLEY, CALIFORNIA 92555

**LEO A DALY**  
550 SOUTH HOPE STREET, SUITE 2700  
LOS ANGELES, CALIFORNIA 90071  
TEL: (213)629-0100 FAX: (213)629-0070

**ARCHITECT STAMP**  
LANCE ARCHITECT  
STATE OF CALIFORNIA  
C-27282  
REN. 7/9/20

**CONSULTANT**

**CONSULTANT STAMP**

**KEY PLAN**

**REVISIONS**

NO.	DESCRIPTION	DATE
01	ADDENDUM 01	04/30/2025

**FILE LOG**

ACTIVITY	BY
Design	Designer
Draw	Author
Check	Checker
Issue Date	20250509

**AGENCY APPLICATION NUMBER**  
**S231455-33-00**

**AGENCY APPROVAL STAMP**

**BUILDING TITLE**  
RIVERSIDE UNIVERSITY HEALTH SYSTEM  
MEDICAL CENTER

**PROJECT TITLE**  
NEW CARDIAC CATHETERIZATION LAB  
SUITE & HYPERBARIC FACILITY EXPANSION

**RHHS MC PROJ. NO.**  
FM08430011869


**CONSULTANT PROJ. NO.**  
047-10071-002

**SHEET NAME**  
**LIFE SAFETY PLAN**


**SHEET NUMBER**  
**G1102**



7/1/2024 7:26:46 PM Autodesk Docs\\047-10071-002\_RUHS-TO-1\_Riverside\_County\_Health\_Cath\_Lab\_RUHS-2ND-CATH-LAB-STRU-4T

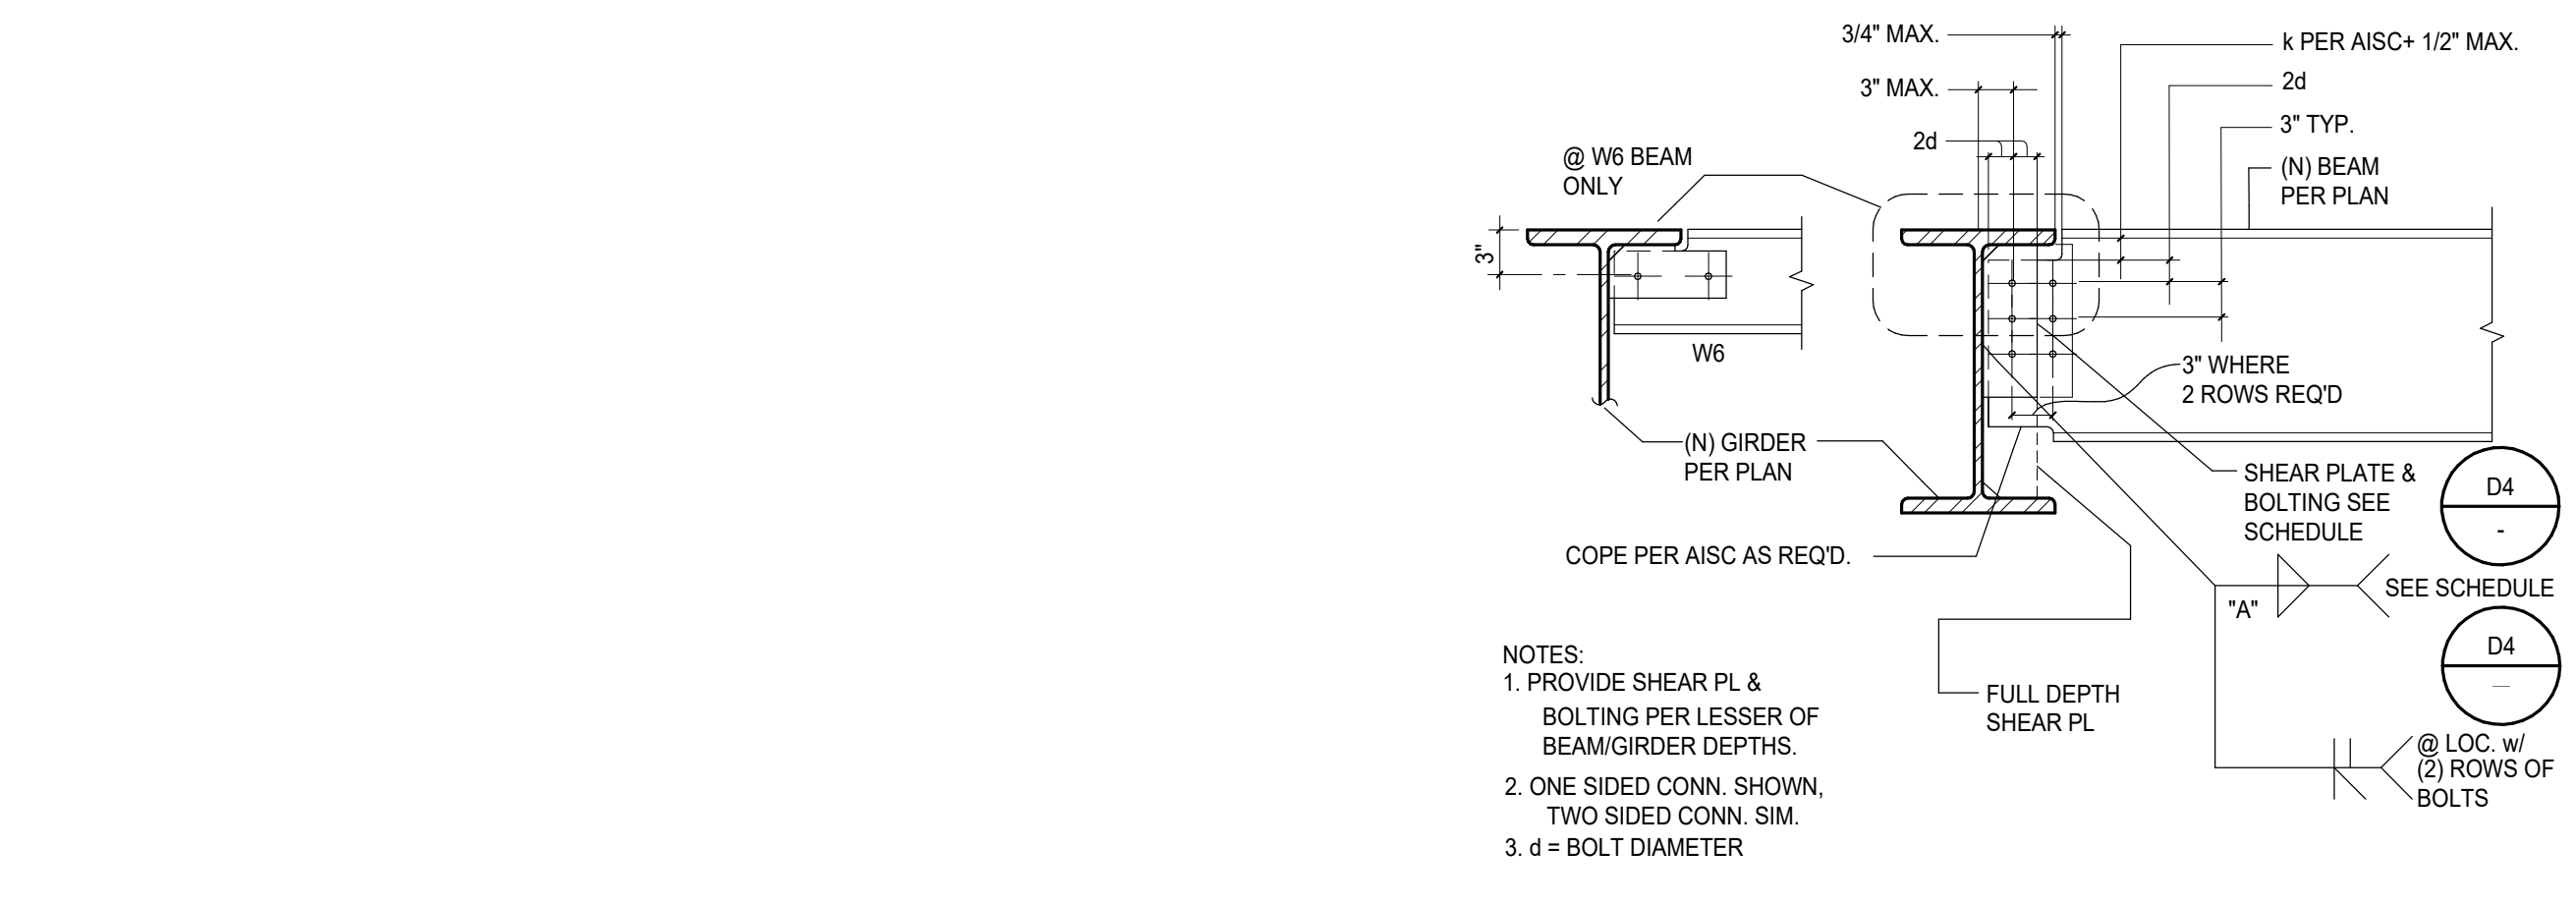

**D2 (N) BEAM TO (N) BEAM SIMPLE CONNECTIONS**  
SCALE: 3/4" = 1'-0"

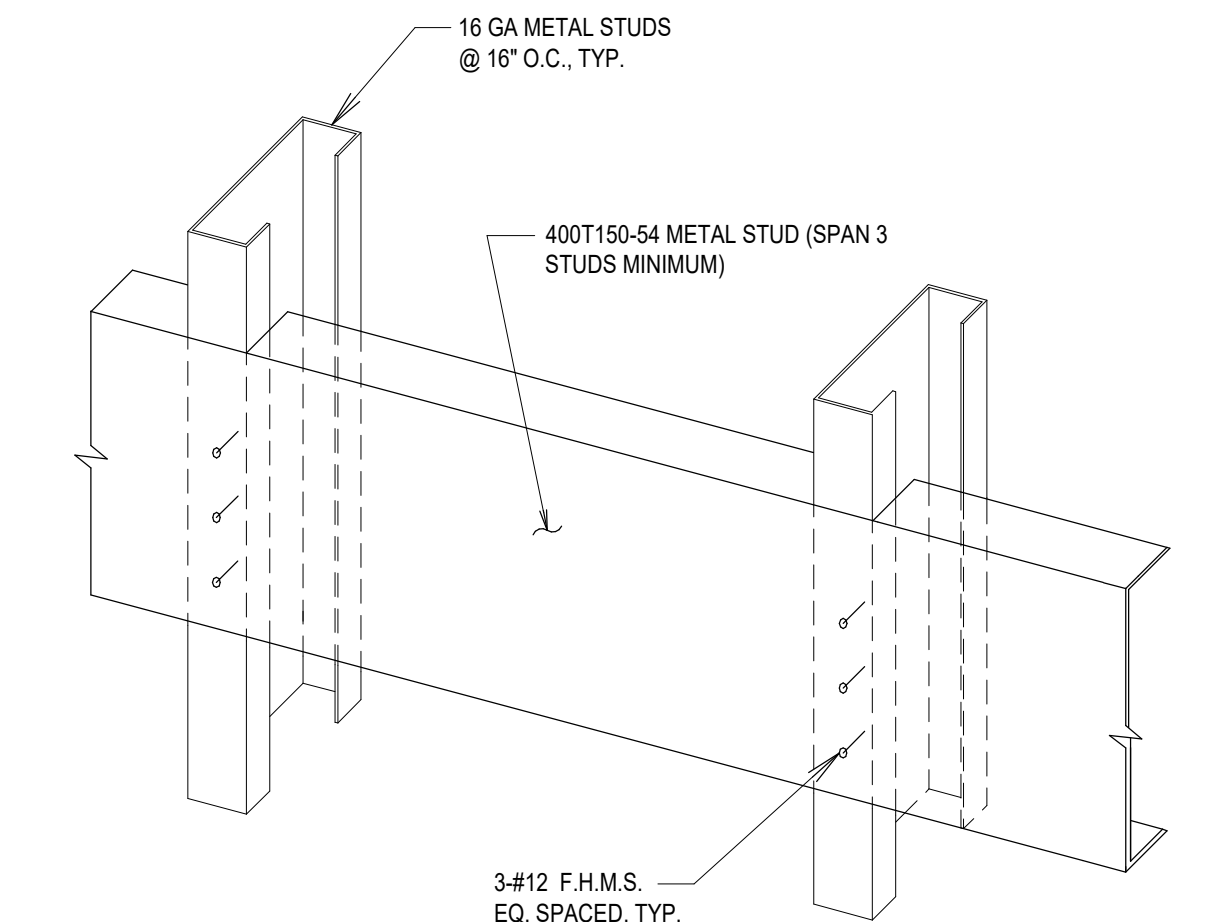


**D3 METAL BACKING**  
SCALE: 1 1/2" = 1'-0"

NOMINAL BEAM/GIRDER DEPTH (1)	MINIMUM PLATE LENGTH (IN)	SHEAR PLATE THICKNESS (IN)	NUMBER OF VERTICAL ROWS OF BOLTS	NUMBER OF BOLTS PER ROW	BOLT DIAMETER (IN) (2)	EDGE DISTANCE (IN)	WELD "A" (2)	ASD DESIGN SHEAR STRENGTH (KIPS)	REMARKS
W8x	6	3/8	1	2	3/4	1 1/2	1/4	8	
W12x & C12	9	3/8	1	3	3/4	1 1/2	1/4	16	
W14x	11	3/8	1	3	1	1 1/2	1/4	29	
W16x	13	1/2	1	4	1	1 1/2	1/4	47	
W18x	15	1/2	1	4	1	2	1/4	47	
W21x	18	1/2	1	5	1 1/8	2	1/4	75	
W24x	20	1/2	1	6	1 1/8	2	1/4	91	
W27x	24	3/4	2	7	1 1/8	2	3/8	217	
W30x	26	1 1/2	2	6	1 1/2	2	1/2	298	

EDGE DISTANCE SEE SCHEDULE  
WELD "A" SEE SCHEDULE  
W OR C SECTION SEE PLAN


**D4 SHEAR PLATE BOLTING SCHEDULE**  
SCALE: 3/4" = 1'-0"

NOTES:  
1. C BEAM CONNECTION SIMILAR TO W BEAM OF SAME DEPTH.  
2. PROVIDE STANDARD AISI-C ROUND HOLES IN SHEAR PLATE.  
3. PROVIDE THE LARGER OF WELD INDICATED & A/W'S MINIMUM.  
4. WELD "A" SHALL BE FILLET WELD ON BOTH SIDES. WELD "A" CAN BE SUBSTITUTED WITH C-F GROOVE WELD WITH BACKING BAR REMOVED.  
5. ALL BOLTS ARE A325 BOLTS PER GENERAL NOTES.  
6. CONNECTION PLATE IS CONFORMING TO A992 OR A572 GRADE 50, Fy=50 KSI, Fu=65 KSI.

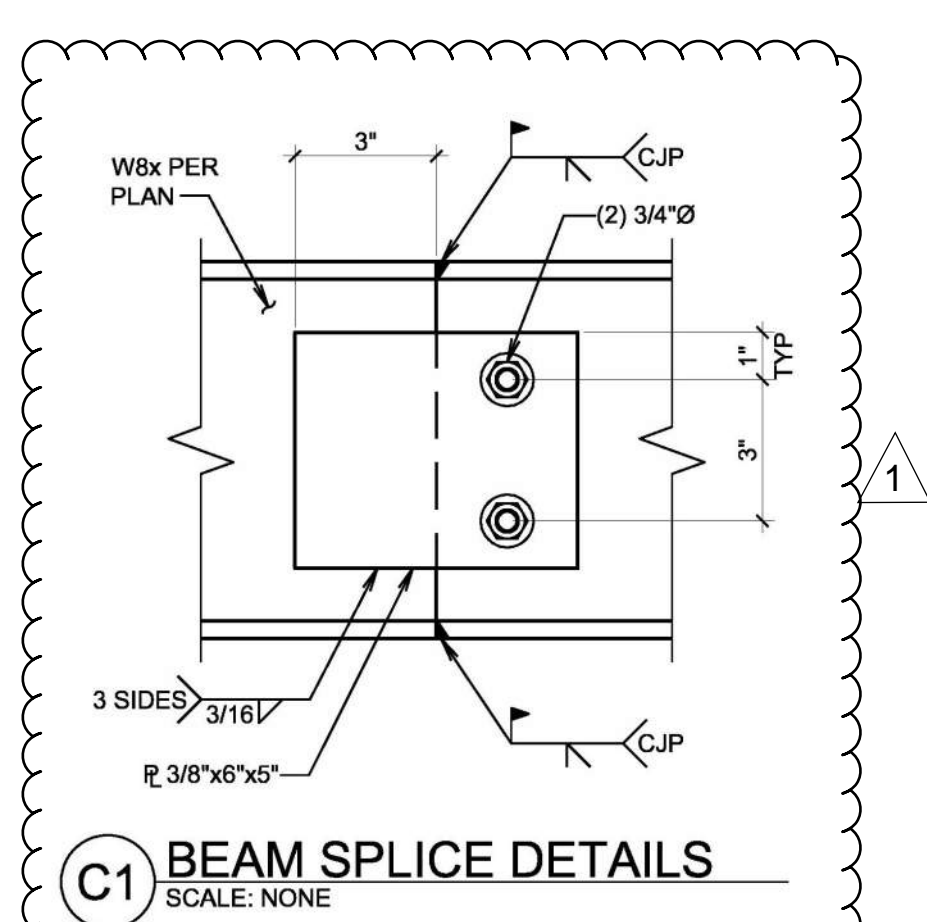


VERCO DECK DEPTH AND SECTION TYPE	DECK WELDS, SEE (A)	WELD (B)	SIDELAP ATTACHMENT
W2	1/2	3	1/2


SIZE AND TYPE	# PER SHEET	SIZE AND TYPE	SPAC-ING	TYPE	SPAC-ING
W2	1/2	3	1/2	12"	1-1/2" TSW

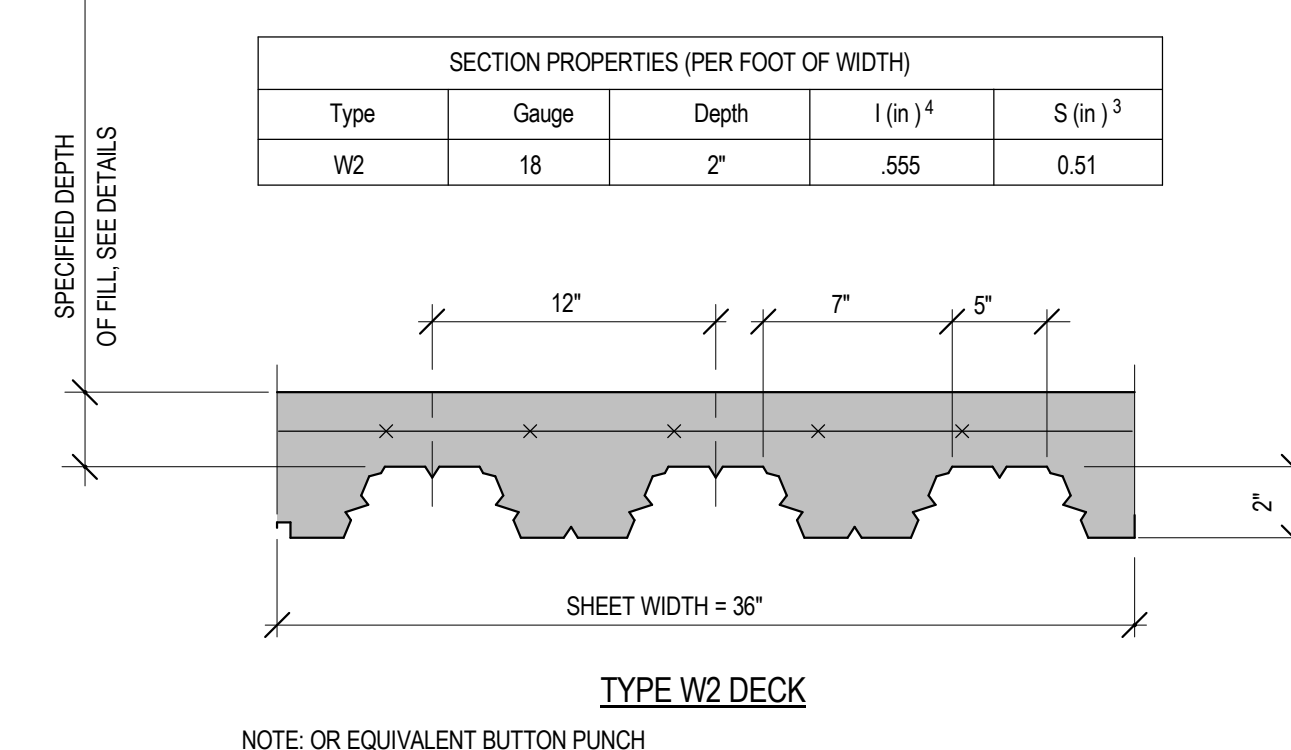


**C2 STEEL BEAM STRENGTHENING**  
SCALE: 1 1/2" = 1'-0"

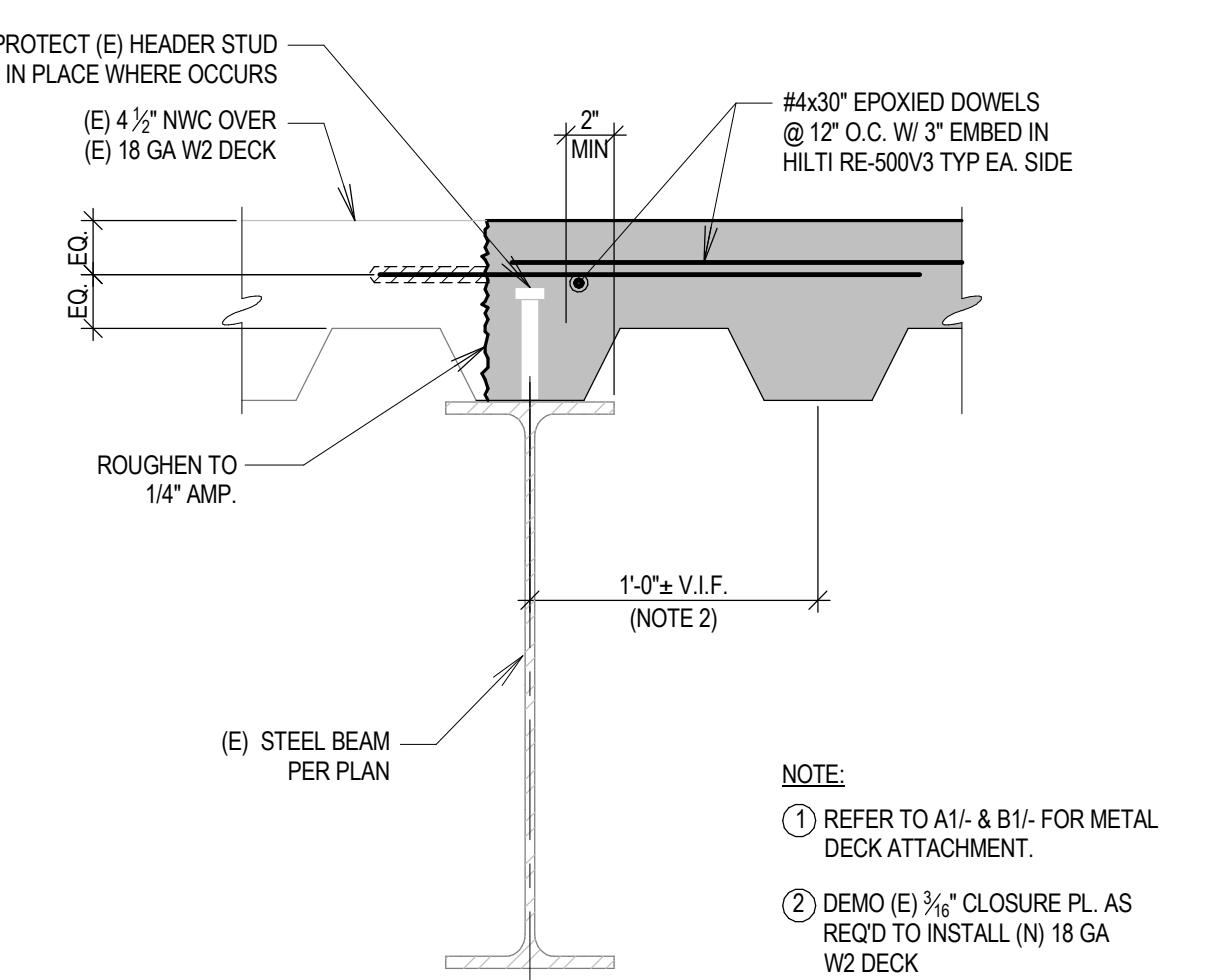


**D3 METAL BACKING**  
SCALE: 1 1/2" = 1'-0"

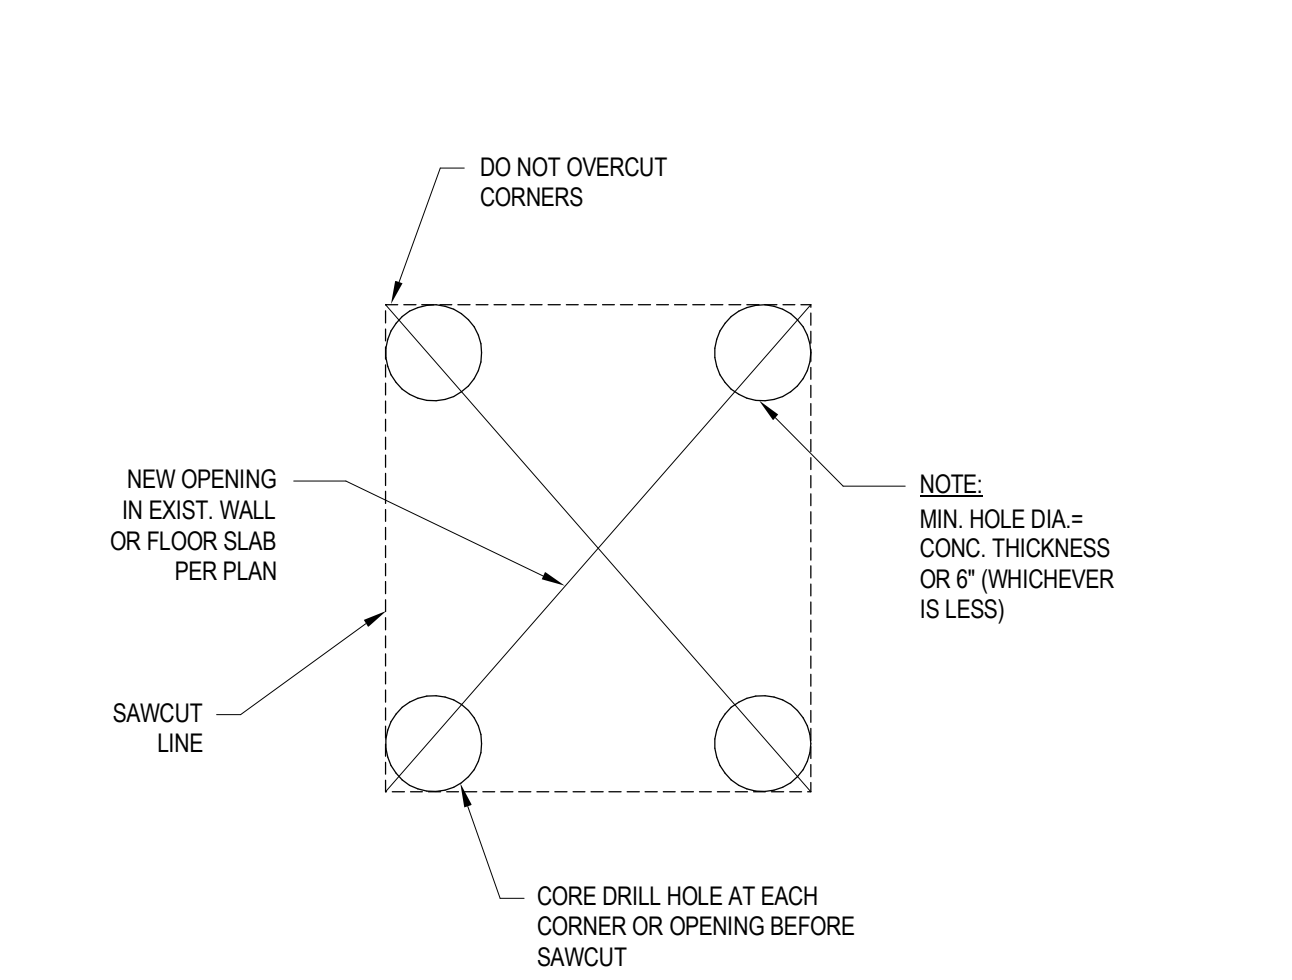


**D4 SHEAR PLATE BOLTING SCHEDULE**  
SCALE: 3/4" = 1'-0"

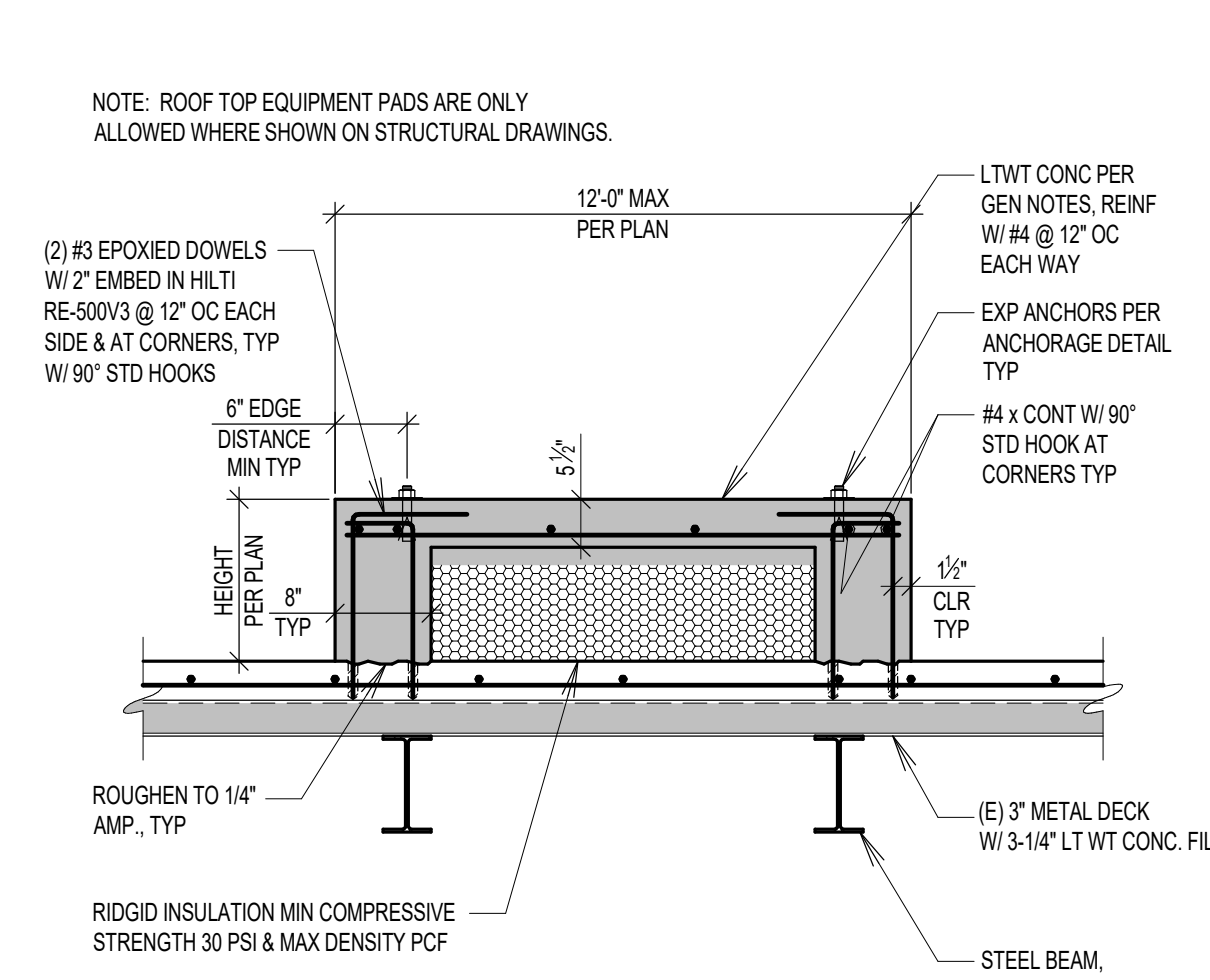


**C5 ROOF TOP EQUIPMENT PAD**  
SCALE: 3/4" = 1'-0"

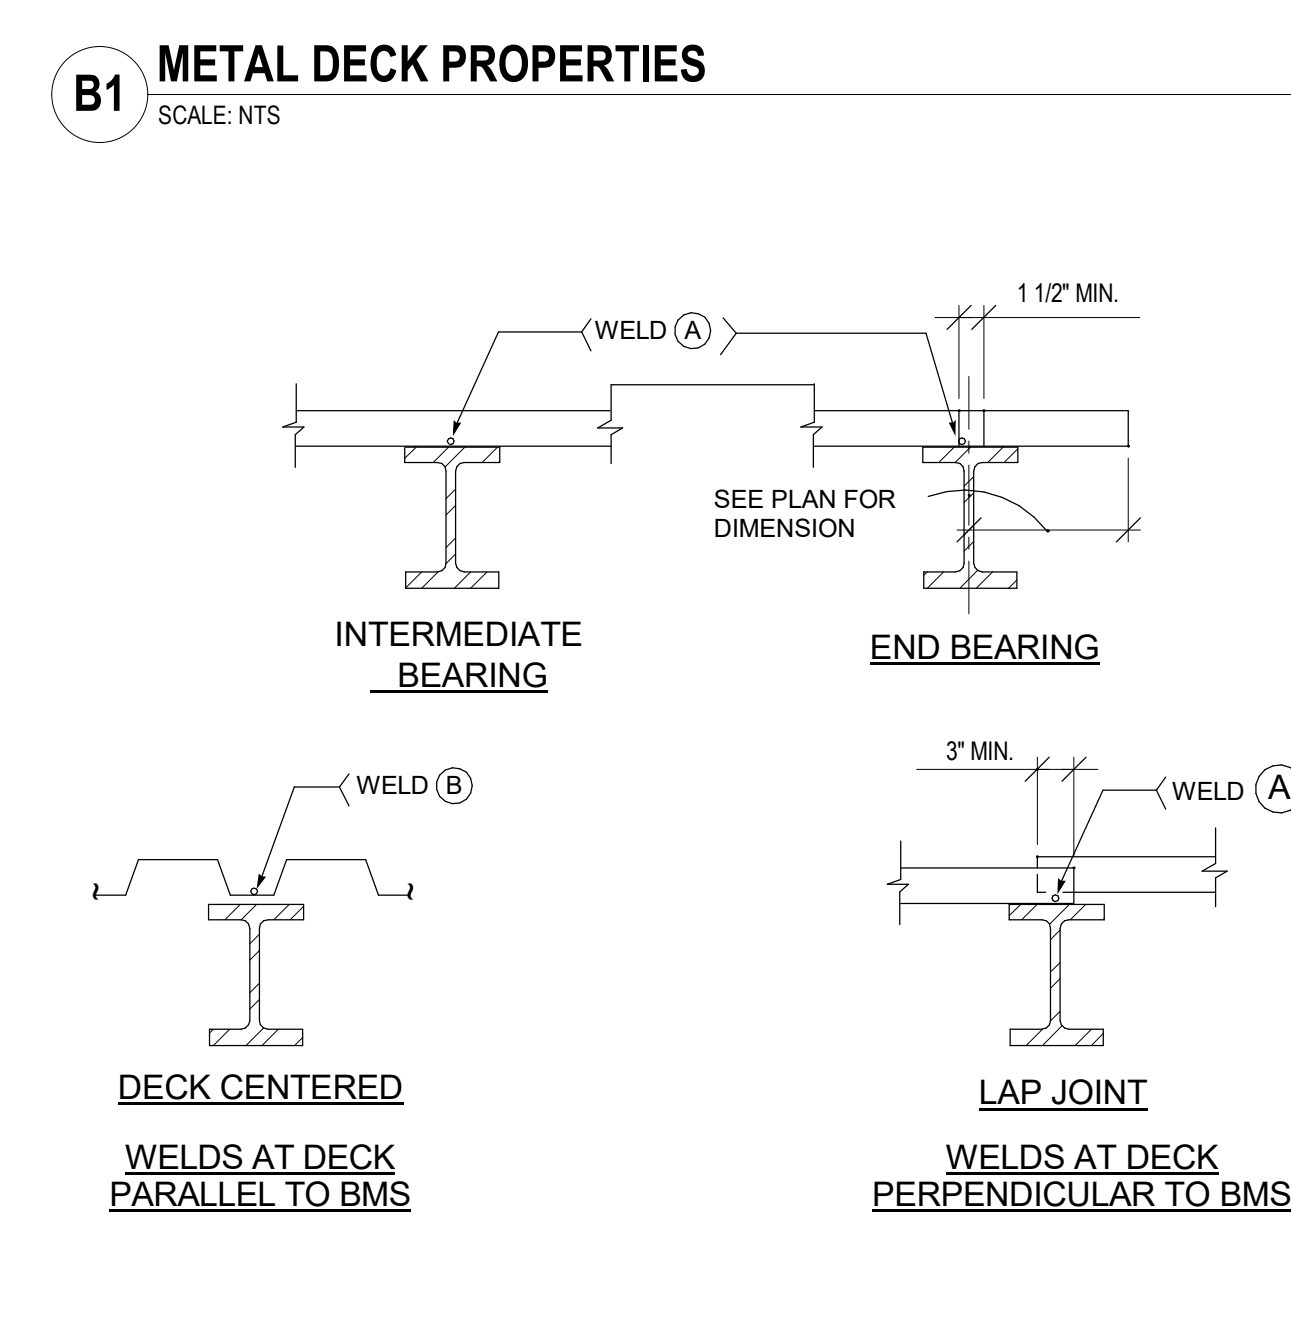


**B1 METAL DECK PROPERTIES**  
SCALE: NTS

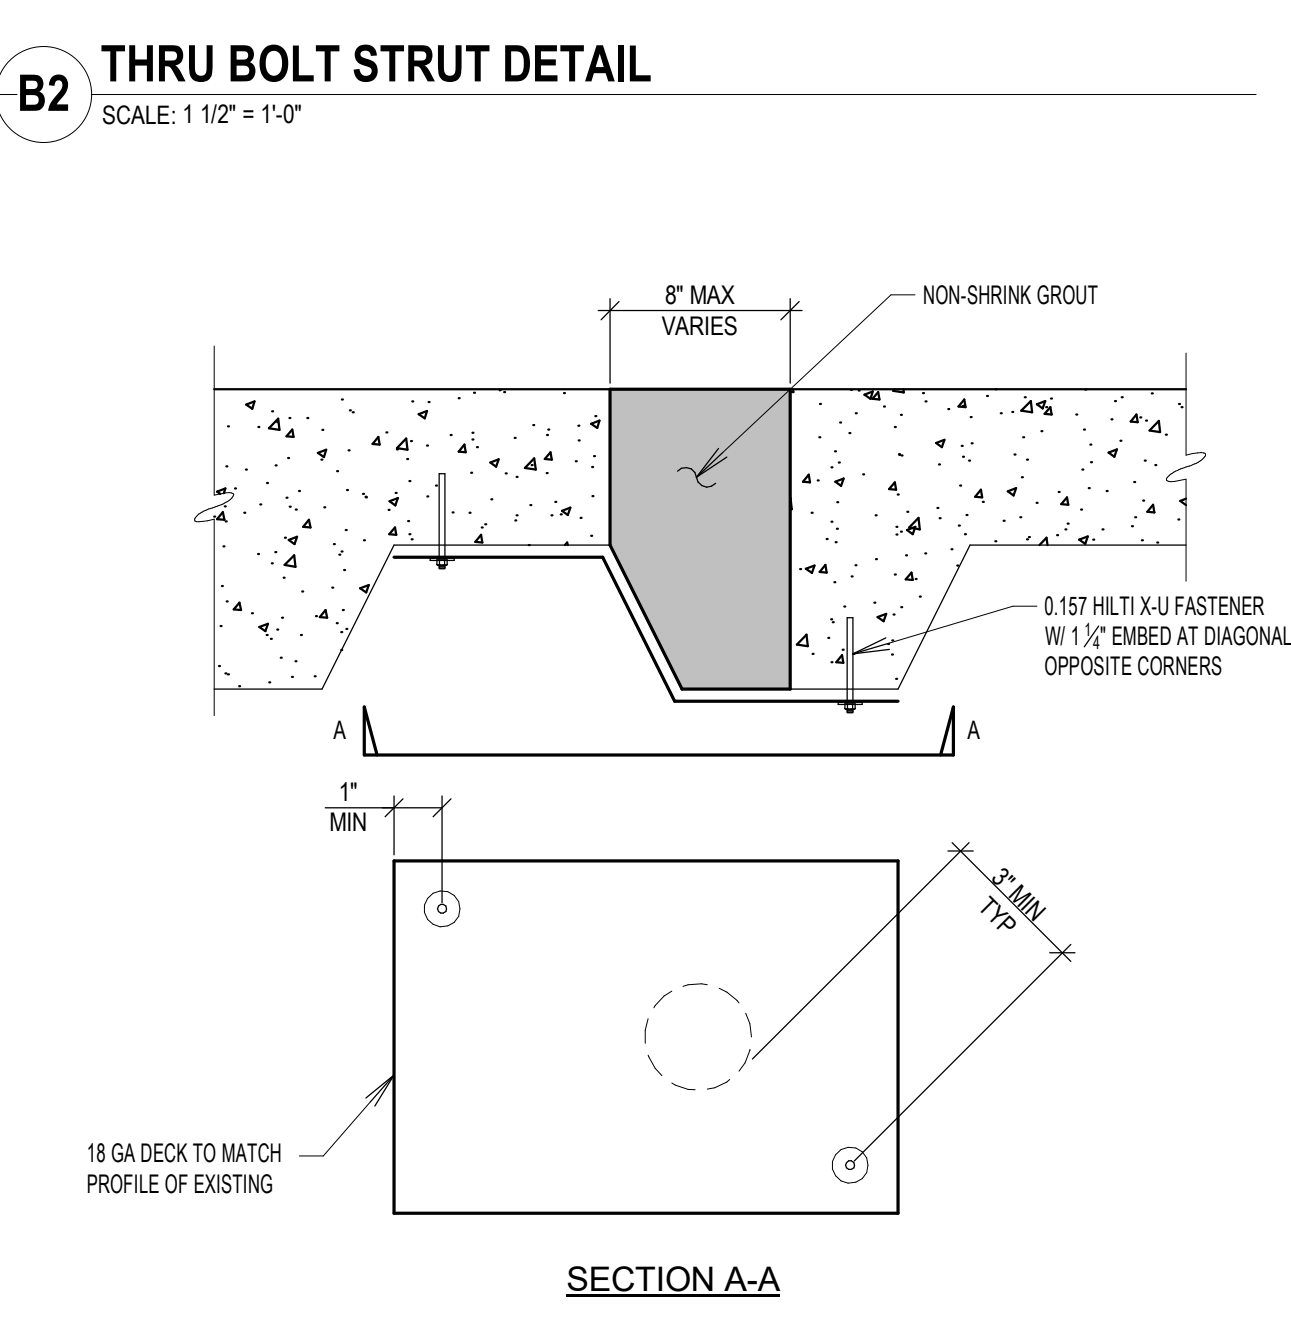


**B2 THRU BOLT STRUT DETAIL**  
SCALE: 1 1/2" = 1'-0"

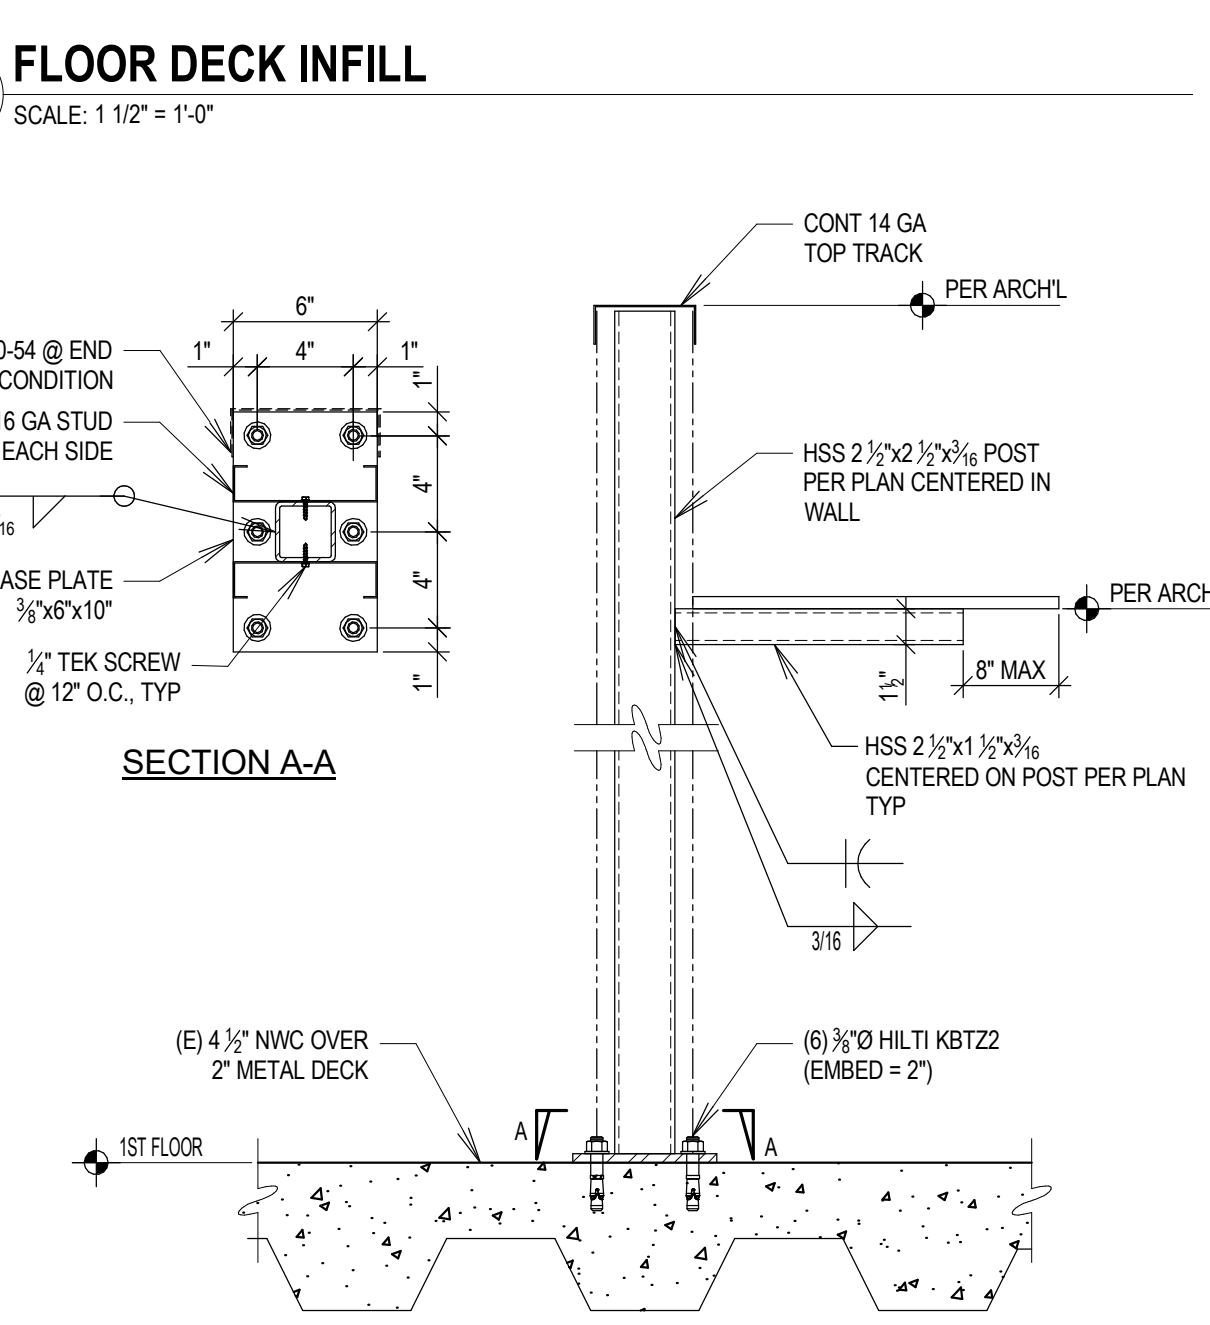

**B3 FLOOR DECK INFILL**  
SCALE: 1 1/2" = 1'-0"

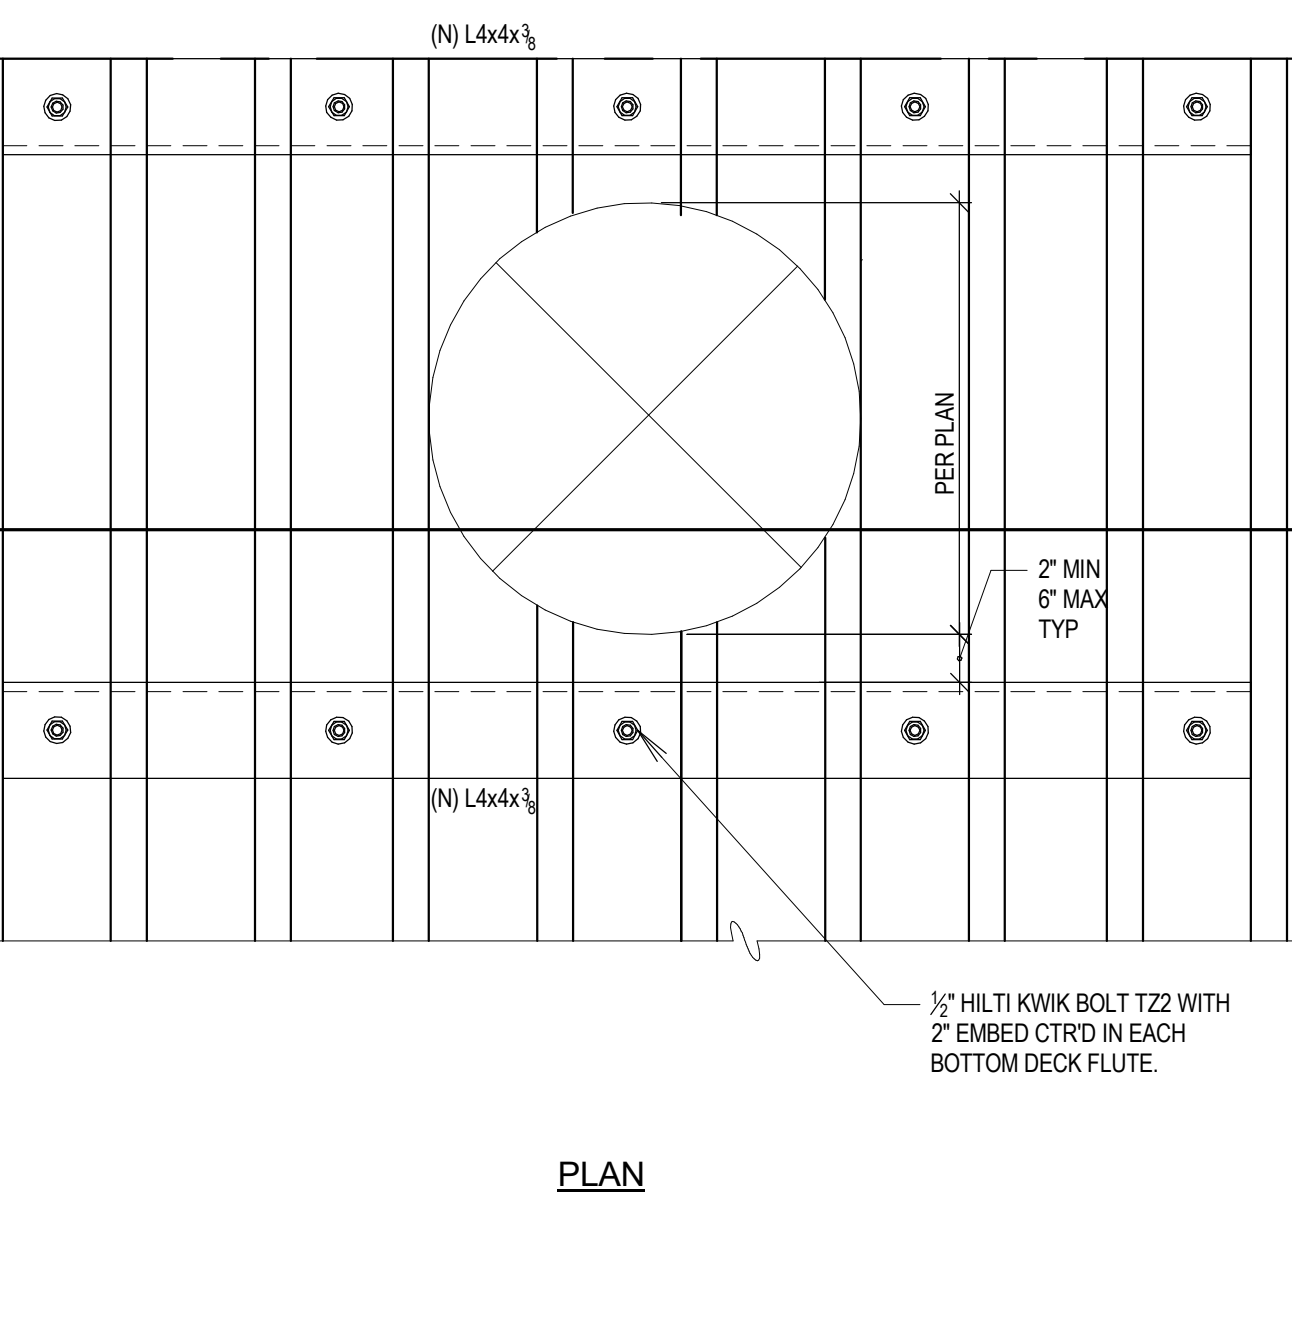

**B5 (N) BEAM TO (E) GIRDER SIMPLE CONNECTIONS**  
SCALE: 3/4" = 1'-0"

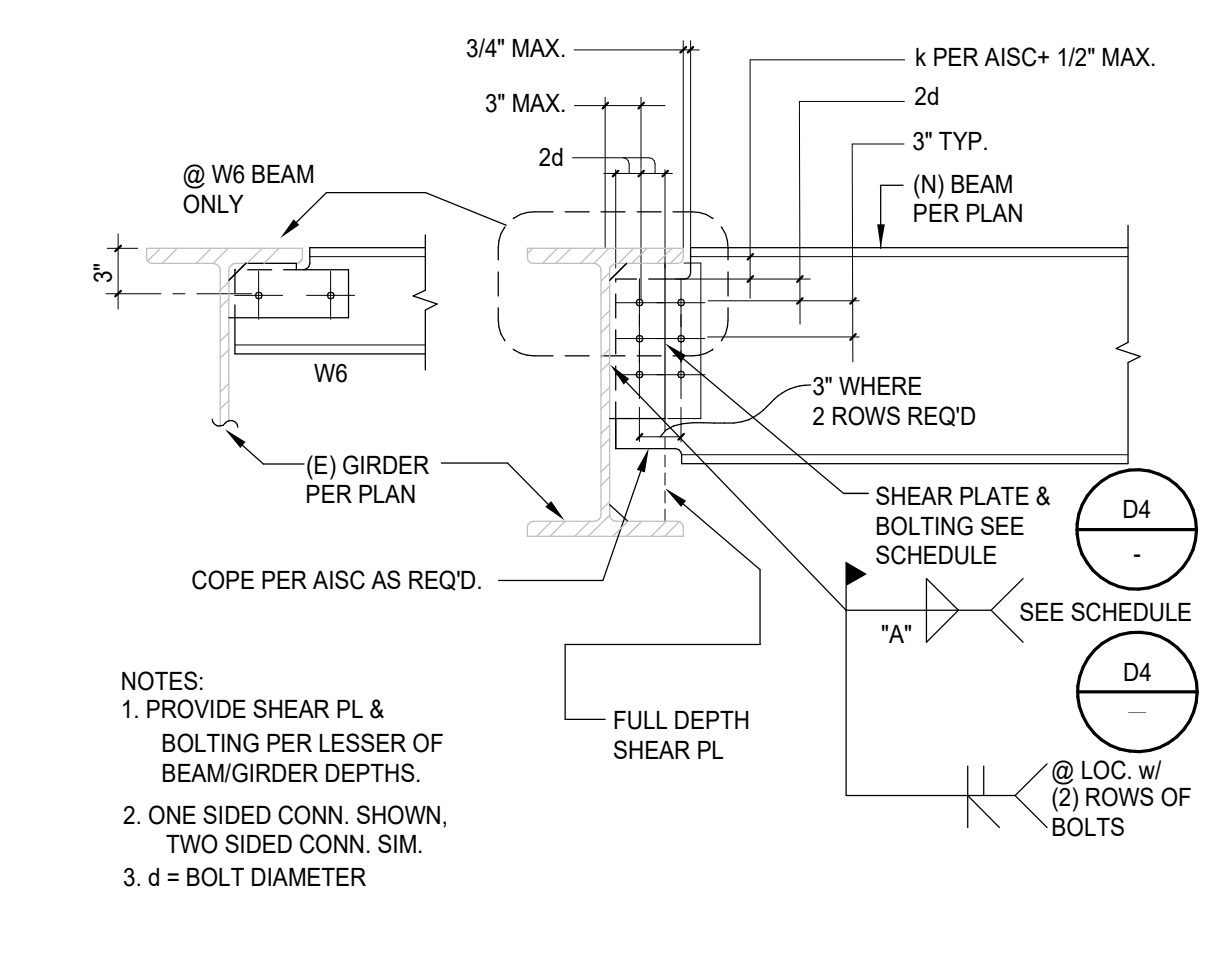

**D2 (N) BEAM TO (N) BEAM SIMPLE CONNECTIONS**  
SCALE: 3/4" = 1'-0"

**RIVERSIDE UNIVERSITY HEALTH SYSTEM**  
MEDICAL CENTER

26520 CACTUS AVENUE, MORENO VALLEY, CALIFORNIA 92555

550 SOUTH HOPE STREET, SUITE 2700  
LOS ANGELES, CALIFORNIA 90071  
TEL: (213)629-0100 FAX: (213)629-0070

ARCHITECT STAMP

CONSULTANT

420 Exchange, Suite 200  
Irvine, CA 92612 USA  
Phone: 714.724-4242

CONSULTANT STAMP

KEY PLAN

REVISIONS

NO.	DESCRIPTION	DATE
1	PLAN CHECK	10/10/2023
BC1	BACK CHECK 01	04/19/2024
BC2	BACK CHECK 02	07/03/2024
A	ADDENDUM 01	04/30/2025

FILE LOG

ACTIVITY	BY
Design	Designer
Draw	Author
Check	Checker
Issue Date	Issue Date

AGENCY APPLICATION NUMBER

S

AGENCY APPROVAL STAMP

BUILDING TITLE

RIVERSIDE UNIVERSITY HEALTH SYSTEM  
MEDICAL CENTER

PROJECT TITLE

CARDIAC CATHETERIZATION LABORATORY  
SUITE PROJECT

RUHS-AC PROJ. NO.	CONSULTANT PROJ. NO.
FM08430011869	047-10071-002

SHEET NAME

TYPICAL DETAILS

SHEET NUMBER

S003





550 SOUTH HOPE STREET, SUITE 2700  
LOS ANGELES, CALIFORNIA 90071  
TEL: (213)629-0100 FAX: (213)629-0070

ARCHITECT STAMP




CONSULTANT

CONSULTANT STAMP


## SHEET NOTES

THIS SHEET IS FOR OVERALL PHASE 1 & 2 DEMO PLAN. REFER TO  
AD152 FOR DETAIL SCOPE OF WORK PER PHASE.

## KEY NOTES - CEILING PLAN

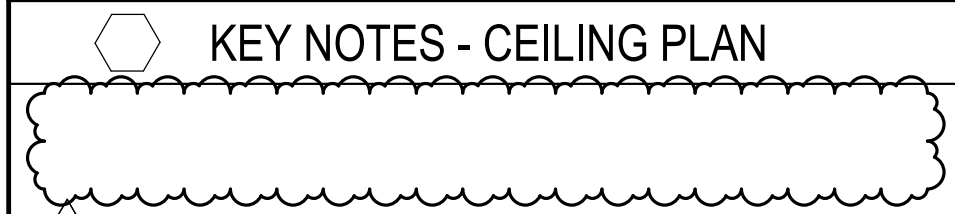

## LEGEND

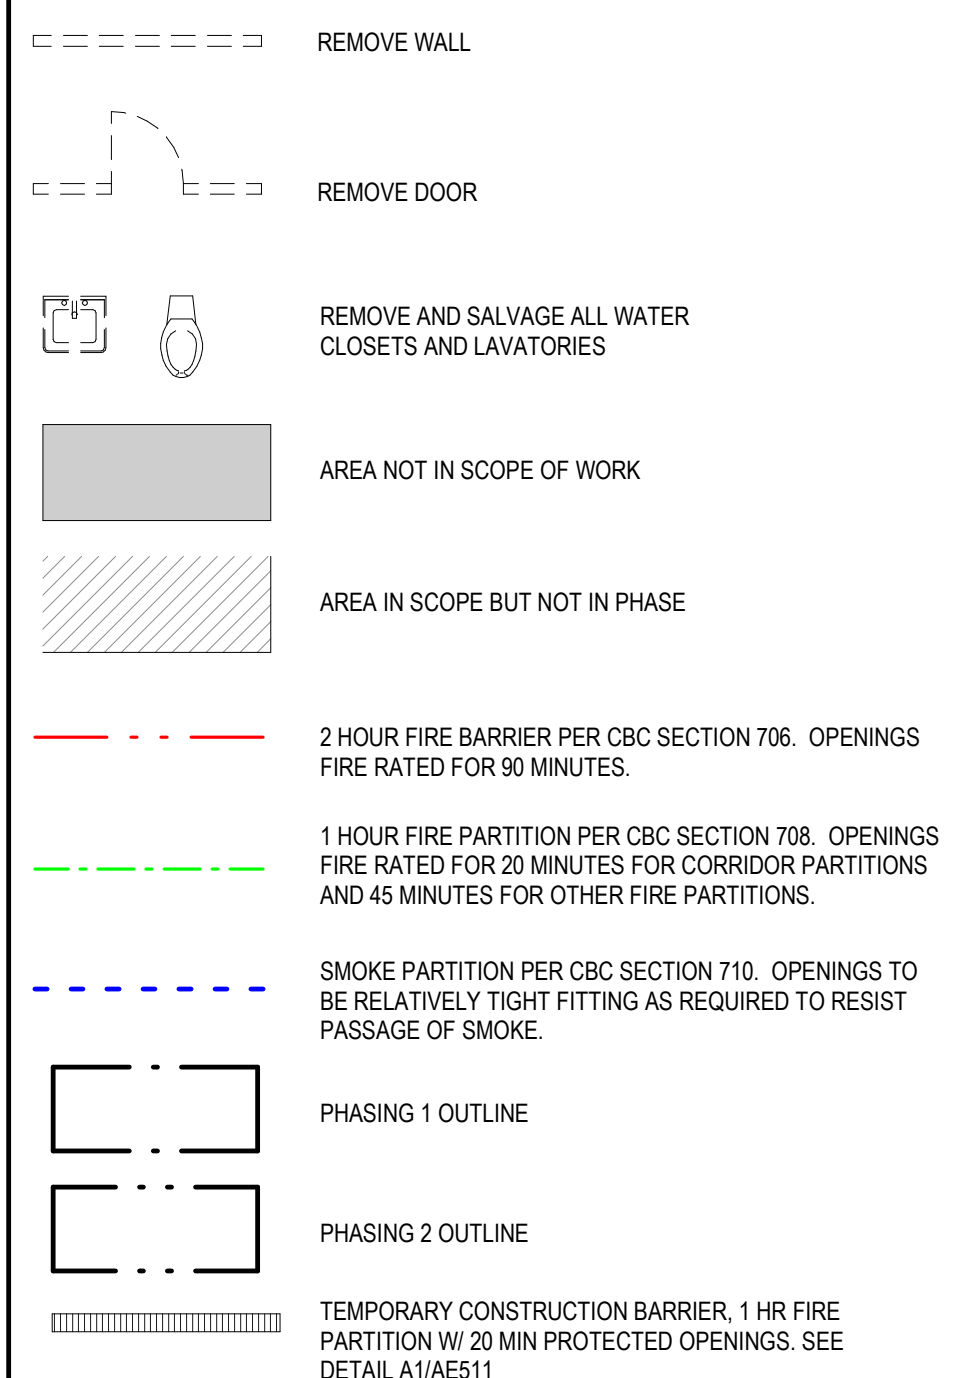

## KEY PLAN

[illegible]

## FILE LOG

Twity	BY
Design	Designer
Draw	Author
Check	Checker
Due Date	2023/8/29

AGENCY APPLICATION NUMBER

231455-33-00

AGENCY APPROVAL STAMP

BUILDING TITLE  
IVERSIDE UNIVERSITY HEALTH SYSTEM  
EDICAL CENTER


PROJECT TITLE  
NEW CARDIAC CATHETERIZATION LAB  
SUITE & HYPERBARIC FACILITY EXPANSION

JHS-MC PROJ. NO.	CONSULTANT PROJ. NO.
100-10001-1000	047-10074-000

SHEET NAME  
OVERALL REFLECTED  
CEILING PLAN - PHASE 1 & 2 -  
DEMO

SHEET NUMBER

AD121

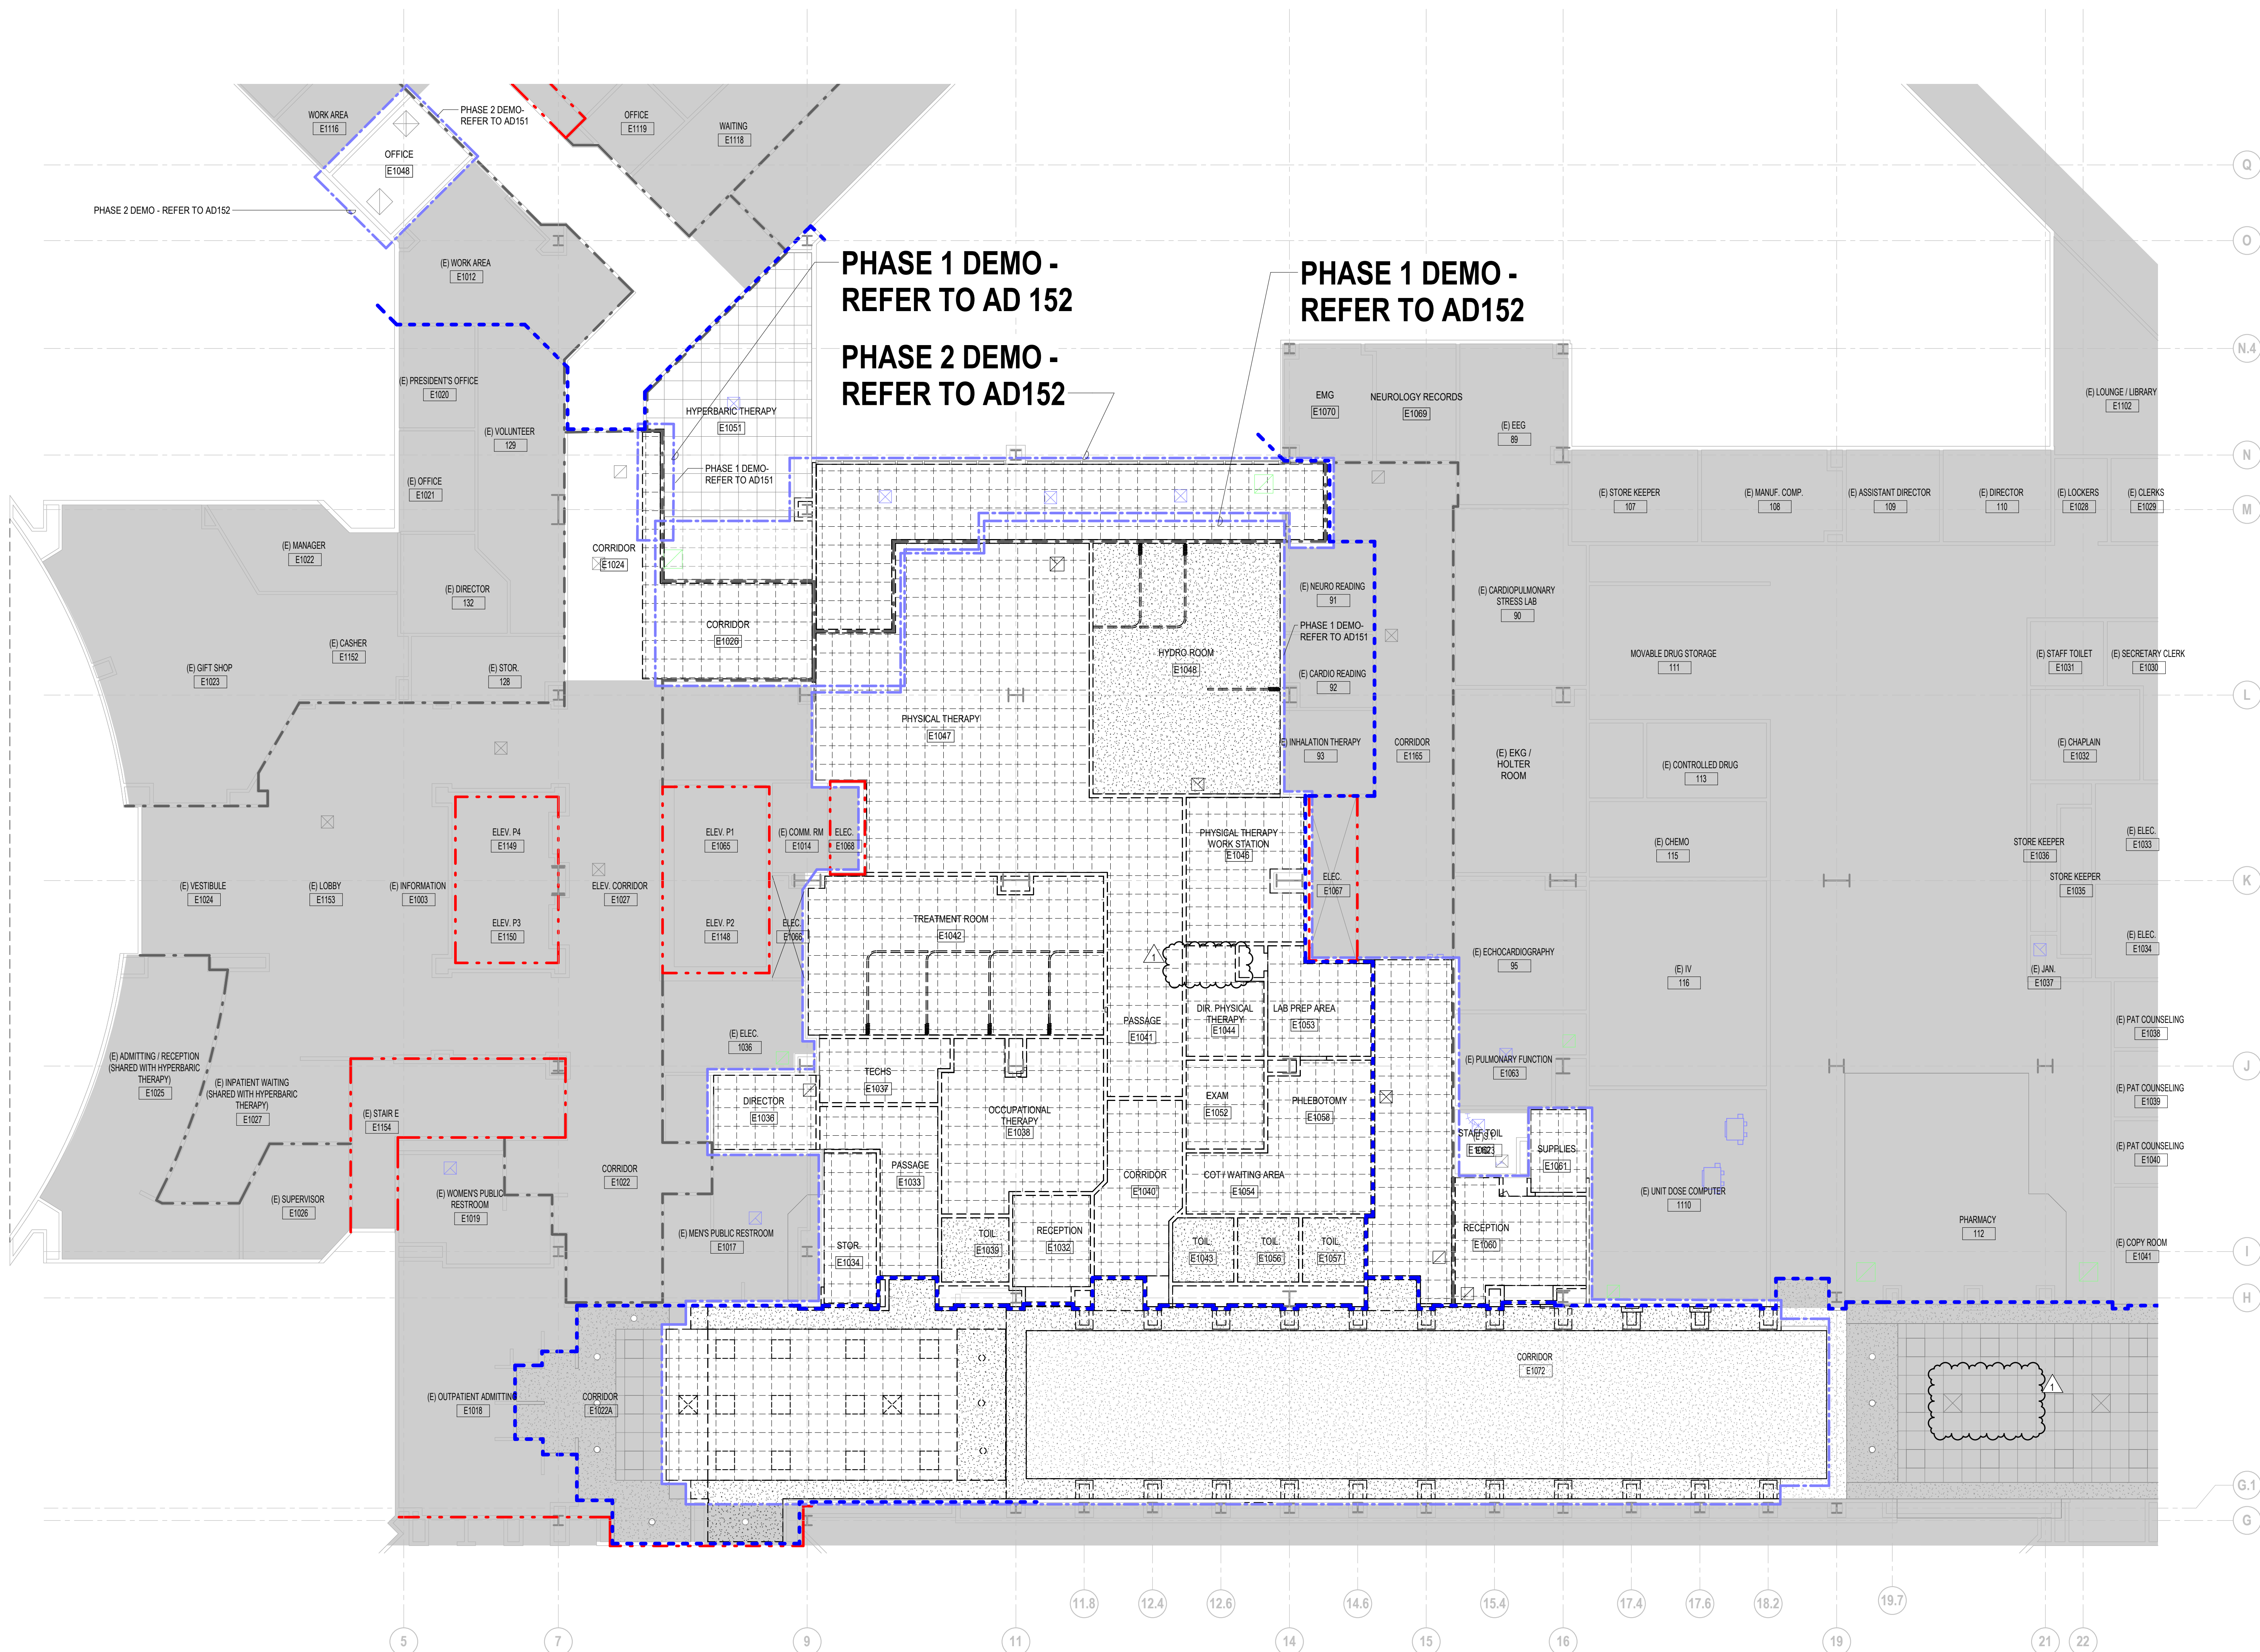

## PARTIAL RELECTED CEILING PLAN - LEVEL 1 - DEMO

SCALE: 1/8" = 1'-0"








5/8/2023 3:11:23 PM Autodesk Docs\\047-10071-002\_RUHS-STO - Riverside County Health Center Lab RUMS AND CATH LAB ARCHIT

**D1 PARTIAL RELECTED CEILING PLAN - LEVEL 1 - PHASE 2 - DEMO**  
SCALE: 1/8" = 1'-0"

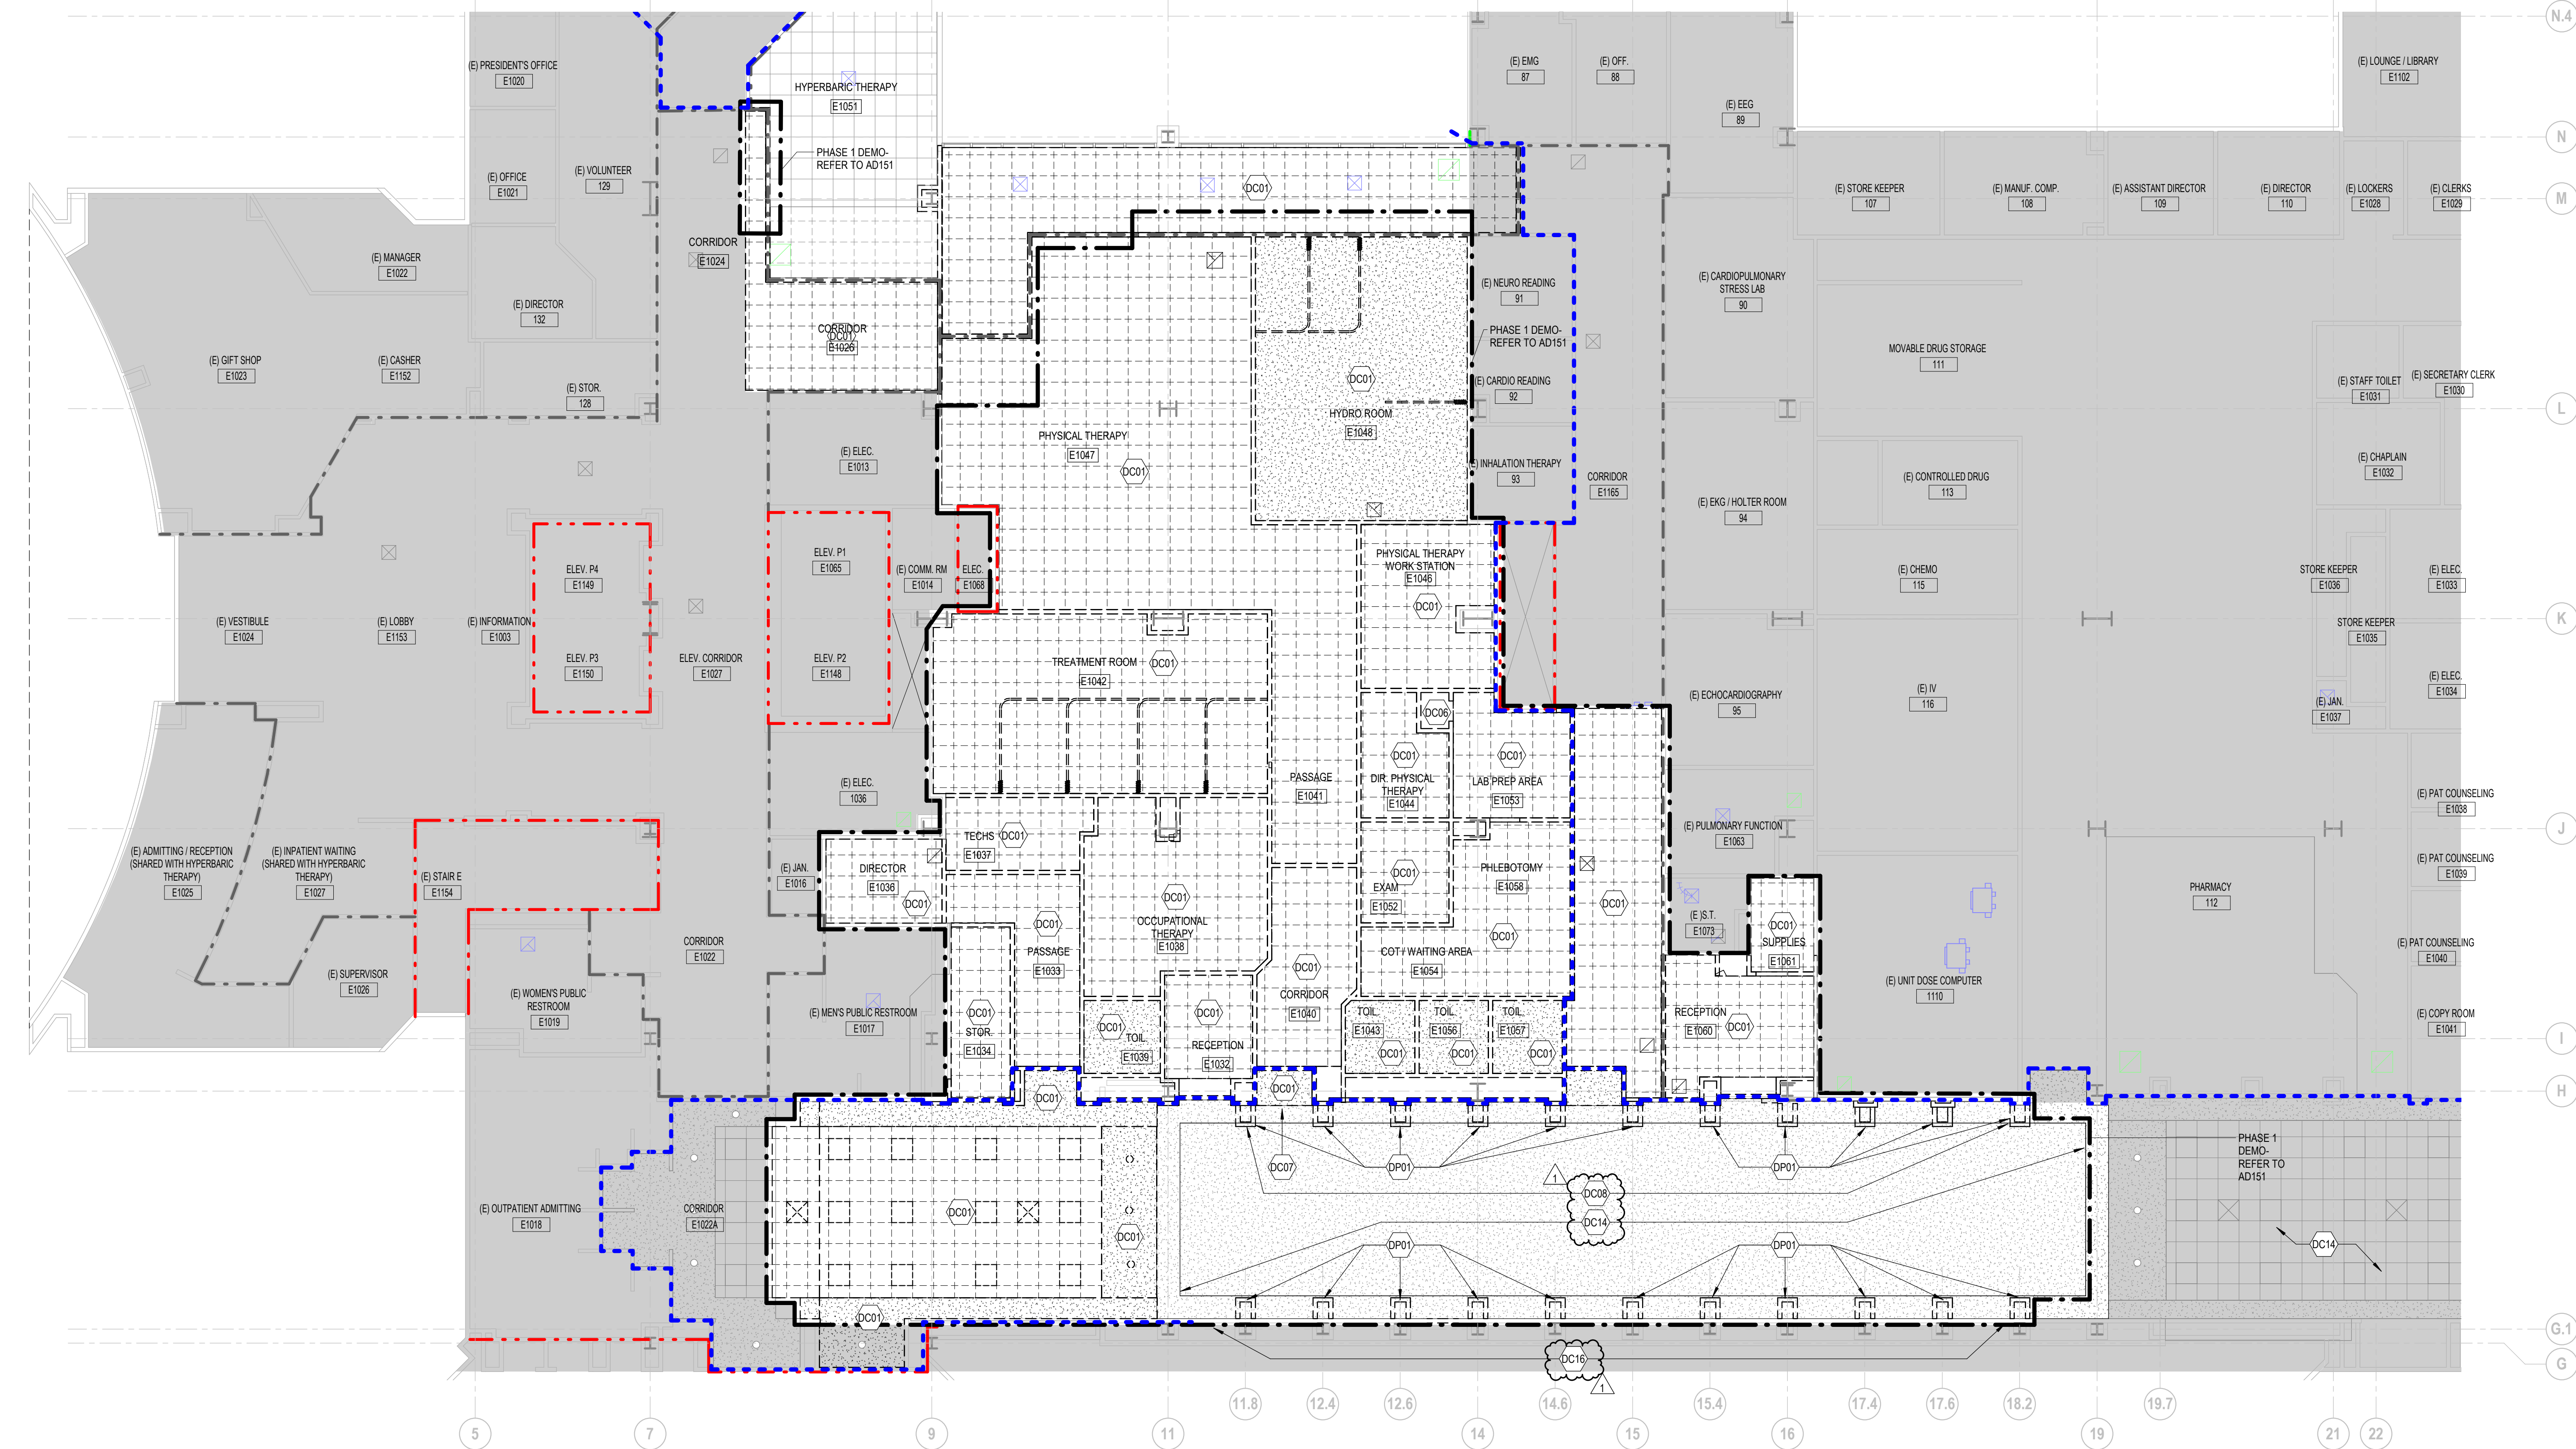

**A1 PARTIAL RELECTED CEILING PLAN - LEVEL 1 - PHASE 1 - DEMO**  
SCALE: 1/8" = 1'-0"


5/8/2023 3:11:23 PM Autodesk Docs\\047-10071-002\_RUHS-STO - Riverside County Health Center Lab RUMS AND CATH LAB ARCHIT

## SHEET NOTES - DEMOLITION

- DEMOLITION NOTES APPLY TO ALL DRAWING SHEETS.
- REMOVE EXISTING FINISHES, ADHESIVES OR OTHER MATERIALS THAT WILL CONFLICT WITH NEW FINISHES SCHEDULED IN EXISTING OR NEWLY REMODELED SPACES. REMOVE OR MODIFY PARTITION, CEILING, BASES AND FLOORING FINISH SUBSTRATES TO ACCOMMODATE NEW FINISHES AS SCHEDULED.
- REMOVE EXISTING PARTITIONS, DOORS, FRAMES, SOFFITS, MILLWORK, FIXTURES, ETC. ON THE DEMOLITION PLAN SHOWN WITH DASHED LINES. TURN SALVAGEABLE ITEMS OVER TO OWNER AT A LOCATION OF THE OWNER'S CHOOSING.
- REMOVE AND SALVAGE EXISTING EQUIPMENT AND WALL MOUNTED ACCESSORIES FOR RELOCATION BY OWNER.
- REMOVE GENERAL MECHANICAL AND ELECTRICAL MATERIAL NOT NECESSARILY SHOWN, BUT REQUIRED TO BE REMOVED TO COMPLETE WORK.
- CUTTING AND PATCHING REQUIRED FOR NEW MECHANICAL AND ELECTRICAL WORK IN EXISTING SPACES SHALL BE BY RESPECTIVE CONTRACTORS.
- CONTRACTOR TO VERIFY WITH OWNER THAT HAZARDOUS MATERIAL SURVEY HAS BEEN COMPLETED FOR MATERIALS TO BE REMOVED/DISTURBED.
- THE CONTRACTOR SHALL VERIFY EXISTING FINISHES AND CONDITION BEFORE CONSTRUCTION BEGINS.
- CONTRACTOR SHALL COORDINATE DEMOLITION WORK PHASING AND SEQUENCING WITH OWNER PRIOR TO START OF CONSTRUCTION.
- ERECT DUST-PROOF PARTITIONS AS REQUIRED BY OWNER AND FIRE MARSHALL TO PROTECT ADJACENT AREA DURING CONSTRUCTION.
- MAINTAIN REQUIRED EXITS AND MEANS OF EGRESS DURING CONSTRUCTION.
- PROTECT MECHANICAL AND ELECTRICAL SERVICES AS REQUIRED TO REMAIN IN OPERATION.
- REMOVE CEILING SYSTEMS AS REQUIRED TO ACCOMMODATE MECHANICAL AND ELECTRICAL WORK. SEE MECHANICAL AND ELECTRICAL DRAWINGS FOR APPROXIMATE LOCATIONS. SALVAGE TILES AND GRID FOR REINSTALLATION WHEN COMPLETE UNLESS NOTED OTHERWISE.
- SEE MECHANICAL AND ELECTRICAL DRAWINGS FOR SCOPE AND EXTENT OF MECHANICAL AND ELECTRICAL WORK.
- DURING THE DEMOLITION PROCESS THERE MAY BE INSTANCES WHERE THE REMOVAL OR ABANDONMENT OF A FIXTURE, DUCT, CONDUIT OR OTHER PIECE OF EQUIPMENT MAY LEAVE AN OPENING IN A REQUIRED FIRE RESISTIVE ASSEMBLY, AS PART OF THE DEMOLITION AND REMODELING PROCESS A FIRE-RESISTIVE MEMBER OR THROUGH-PENETRATION (AND/OR OPEN JOINT) RESULTING FORM SUCH DESTRUCTION WOULD BE REQUIRED TO BE REINSTALLED IN ACCORDANCE WITH CBC FOR THE NECESSARY RATING PROTECTION. PROVISIONS FOR REQUIRED FIRESTOP CONDITIONS SHALL BE INCLUDED AS PART OF THIS SECTION.
- PATCH EXISTING TO REMAIN BUILDING COMPONENTS IF DAMAGED DURING DEMOLITION. MATCH ADJACENT MATERIALS AND FINISHES.
- COORDINATE WITH THE OWNER FOR THE STORAGE AND RELOCATION REQUIREMENTS OF EXISTING AND SALVAGED ITEMS.
- VERIFY EXISTING SPRINKLER SYSTEM WITH SPRINKLER CONTRACTOR PRIOR TO DEMOLITION. SPRINKLER CONTRACTOR TO MODIFY AND MAINTAIN SYSTEM CODE REQUIREMENTS THROUGHOUT THE PROJECT.
- CONTRACTOR SHALL REMOVE/MODIFY EXISTING GYPSUM BOARD AND ACT CEILINGS AS NECESSARY FOR NEW CEILING LAYOUT AND MECHANICAL DUCTWORK. SEE CEILING PLAN FOR NEW CEILING LAYOUT.
- CONTRACTOR SHALL REMOVE OWNERS EXISTING WALL MOUNTED ITEMS AND TURN OVER TO OWNERS STOCK IN DEMOLITION AREAS.
- CONTRACTOR TO EVALUATE MOISTURE MITIGATION AT SLAB AFTER FLOORING DEMOLITION. VERIFY FLOORING FINISHES INSTALLATION AND WARRANTY REQUIREMENTS FROM MANUFACTURER.
- USE AND PATHWAY OF TEMPORARY CONSTRUCTION WALLS AND TEMP DUST BARRIERS SHALL MEET THE REQUIREMENTS OF THE 2022 CFC, SECTION 3306.9 AND COMPLY WITH THE HOSPITAL INFECTION CONTROL REQUIREMENTS. TEMPORARY DUST BARRIER MATERIAL SHALL SATISFY ONE OF THE FOLLOWING:  
1. NONCOMBUSTIBLE MATERIALS.  
2. MATERIALS THAT EXHIBIT A FLAME SPREAD INDEX NOT EXCEEDING 25 WHEN TESTED IN ACCORDANCE WITH ASTM E84 OR UL 723.  
3. MATERIALS EXHIBITING A PEAK HEAT RELEASE RATE NOT EXCEEDING 300 KW/M2 WHEN TESTED IN ACCORDANCE WITH ASTM E1363 AT AN INCIDENT HEAT FLUX OF 50 KW/M2 IN THE HORIZONTAL ORIENTATION ON SPECIMENS AT THE THICKNESS INTENDED FOR USE. PLEASE NOTE: IF THE MATERIAL IS TO COMPLY WITH ITEM #2 IDENTIFIED ABOVE, PLEASE BE SURE THE MATERIAL HAS A CLASS A FLAME SPREAD AND/OR DOES NOT EXCEED A FLAME SPREAD INDEX OF 25.

## KEY NOTES - DEMOLITION

- DC01 DEMOLISH EXISTING CEILING DEVICES, DUCTWORK (SERVING AREA OF WORK), MEDICAL GAS OUTLETS (WHERE OCCURS), AND HVAC REGISTERS. CAP ALL UTILITIES AS REQUIRED DURING CONSTRUCTION. PROTECT EXISTING SPRINKLER PIPING IN PLACE.
- DC02 REMOVE EXISTING DUMBWATER.
- DC07 PROTECT IN PLACE EXISTING DOUBLE-HEIGHT VOLUMN WALL. LOCALLY DEMO ONLY AS NEEDED FOR INSTALLATION OF NEW WORK.
- DC08 CAREFULLY REMOVE EXISTING MURAL PANELS AND COORDINATE WITH OWNER FOR RELEASE TO STORE OR RELOCATION.
- DC14 EXISTING VAULTED CEILING TO REMAIN WHERE NOT IMPACTED BY NEW CONSTRUCTION. LOCALLY DEMO CEILING ONLY WHERE NEEDED FOR INSTALLATION OF NEW WORK. V.I.F.
- DC16 EXISTING GLAZING TO BE REPLACED WITH SPANDREL GLASS, PER PLAN AND PER WINDOW SCHEDULE ON AE01. PROTECT EXISTING WINDOW FRAMES IN PLACE.

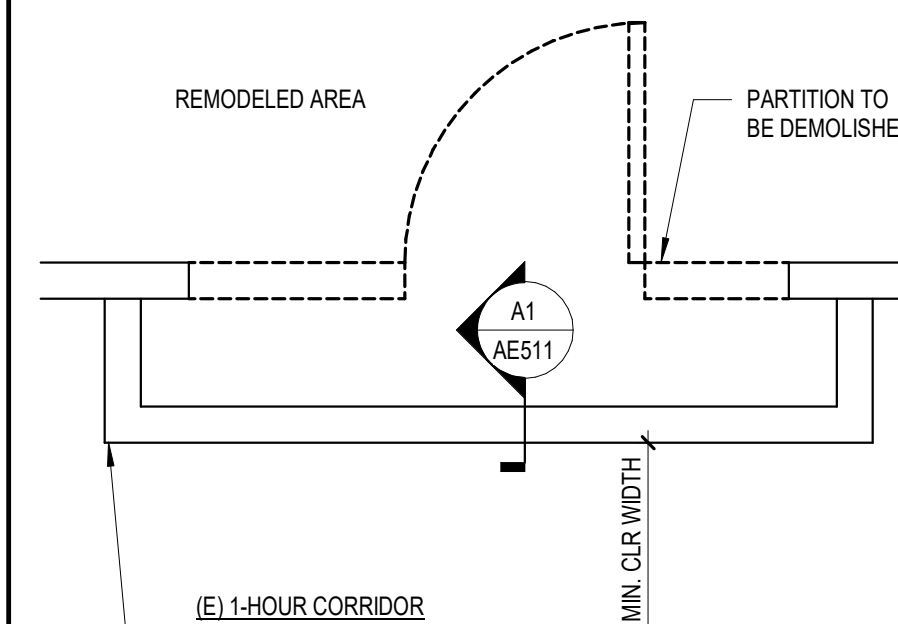

TEMPORARY 1-HR RATED BARRIERS SHALL BE MIN. 2 1/2" 20 GA. METAL STUDS WITH TYPE X GYP. BD. BOTH SIDES. BARRIERS SHALL EXTEND TO UNDERSIDE OF RATED FLOOR/ROOF DECK OR RATED CORRIDOR TUNNEL OR RETURNED HORIZONTALLY BACK TO THE RATED WALL.

DOORS AND HOLLOW METAL FRAME SHALL BE RATED AS REQ'D FOR THE PARTITIONS/BARRIERS BEING REMODELED. DOORS WILL HAVE MIN. 20 MIN. H.M. FRAMES/DOORS.

## LEGEND

- REMOVE WALL
- REMOVE DOOR
- REMOVE AND SALVAGE ALL WATER CLOSETS AND LAVATORIES
- AREA NOT IN SCOPE OF WORK
- AREA IN SCOPE BUT NOT IN PHASE
- 2 HOUR FIRE BARRIER PER CBC SECTION 706. OPENINGS FIRE RATED FOR 90 MINUTES.
- 1 HOUR FIRE PARTITION PER CBC SECTION 708. OPENINGS FIRE RATED FOR 20 MINUTES FOR CORRIDOR PARTITIONS AND 45 MINUTES FOR OTHER FIRE PARTITIONS.
- SMOKE PARTITION PER CBC SECTION 710. OPENINGS TO BE RELATIVELY TIGHT FITTING AS REQUIRED TO RESIST PASSAGE OF SMOKE.
- PHASING 1 OUTLINE
- PHASING 2 OUTLINE
- TEMPORARY CONSTRUCTION BARRIER 1 HR FIRE PARTITION W/ 20 MIN PROTECTED OPENINGS. SEE DETAIL A1/AE11



**RIVERSIDE UNIVERSITY HEALTH SYSTEM MEDICAL CENTER**

26520 CACTUS AVENUE, MORENO VALLEY, CALIFORNIA 92555



550 SOUTH HOPE STREET, SUITE 2700  
LOS ANGELES, CALIFORNIA 90071  
TEL: (213)629-0100 FAX: (213)629-0070

ARCHITECT STAMP



CONSULTANT

CONSULTANT STAMP

KEY PLAN

REVISIONS

NO.	DESCRIPTION	DATE
01	ADDENDUM 01	04/30/2025

FILE LOG

ACTIVITY	BY
Design	Designer
Check	Author
Check	Checker
Issue Date	2023/05/08
AGENCY APPLICATION NUMBER	<b>S231455-33-00</b>
AGENCY APPROVAL STAMP	

BUILDING TITLE  
**RIVERSIDE UNIVERSITY HEALTH SYSTEM MEDICAL CENTER**

PROJECT TITLE  
**NEW CARDIAC CATHETERIZATION LAB SUITE & HYPERBARIC FACILITY EXPANSION**

RUHS-MC PROJ. NO.  
**FM08430011869**

CONSULTANT PROJ. NO.  
**047-10071-002**

SHEET NAME

**PHASING PLAN - LEVEL 1 - REFLECTED CEILING PLAN - DEMO**

SHEET NUMBER


**AD152**







5/8/2023 11:28 PM Autodesk Docs:1047-1007-1002\_RUHS-TO - Riverside County Health Care Lab RUMS AND CATH LAB ARCHIT

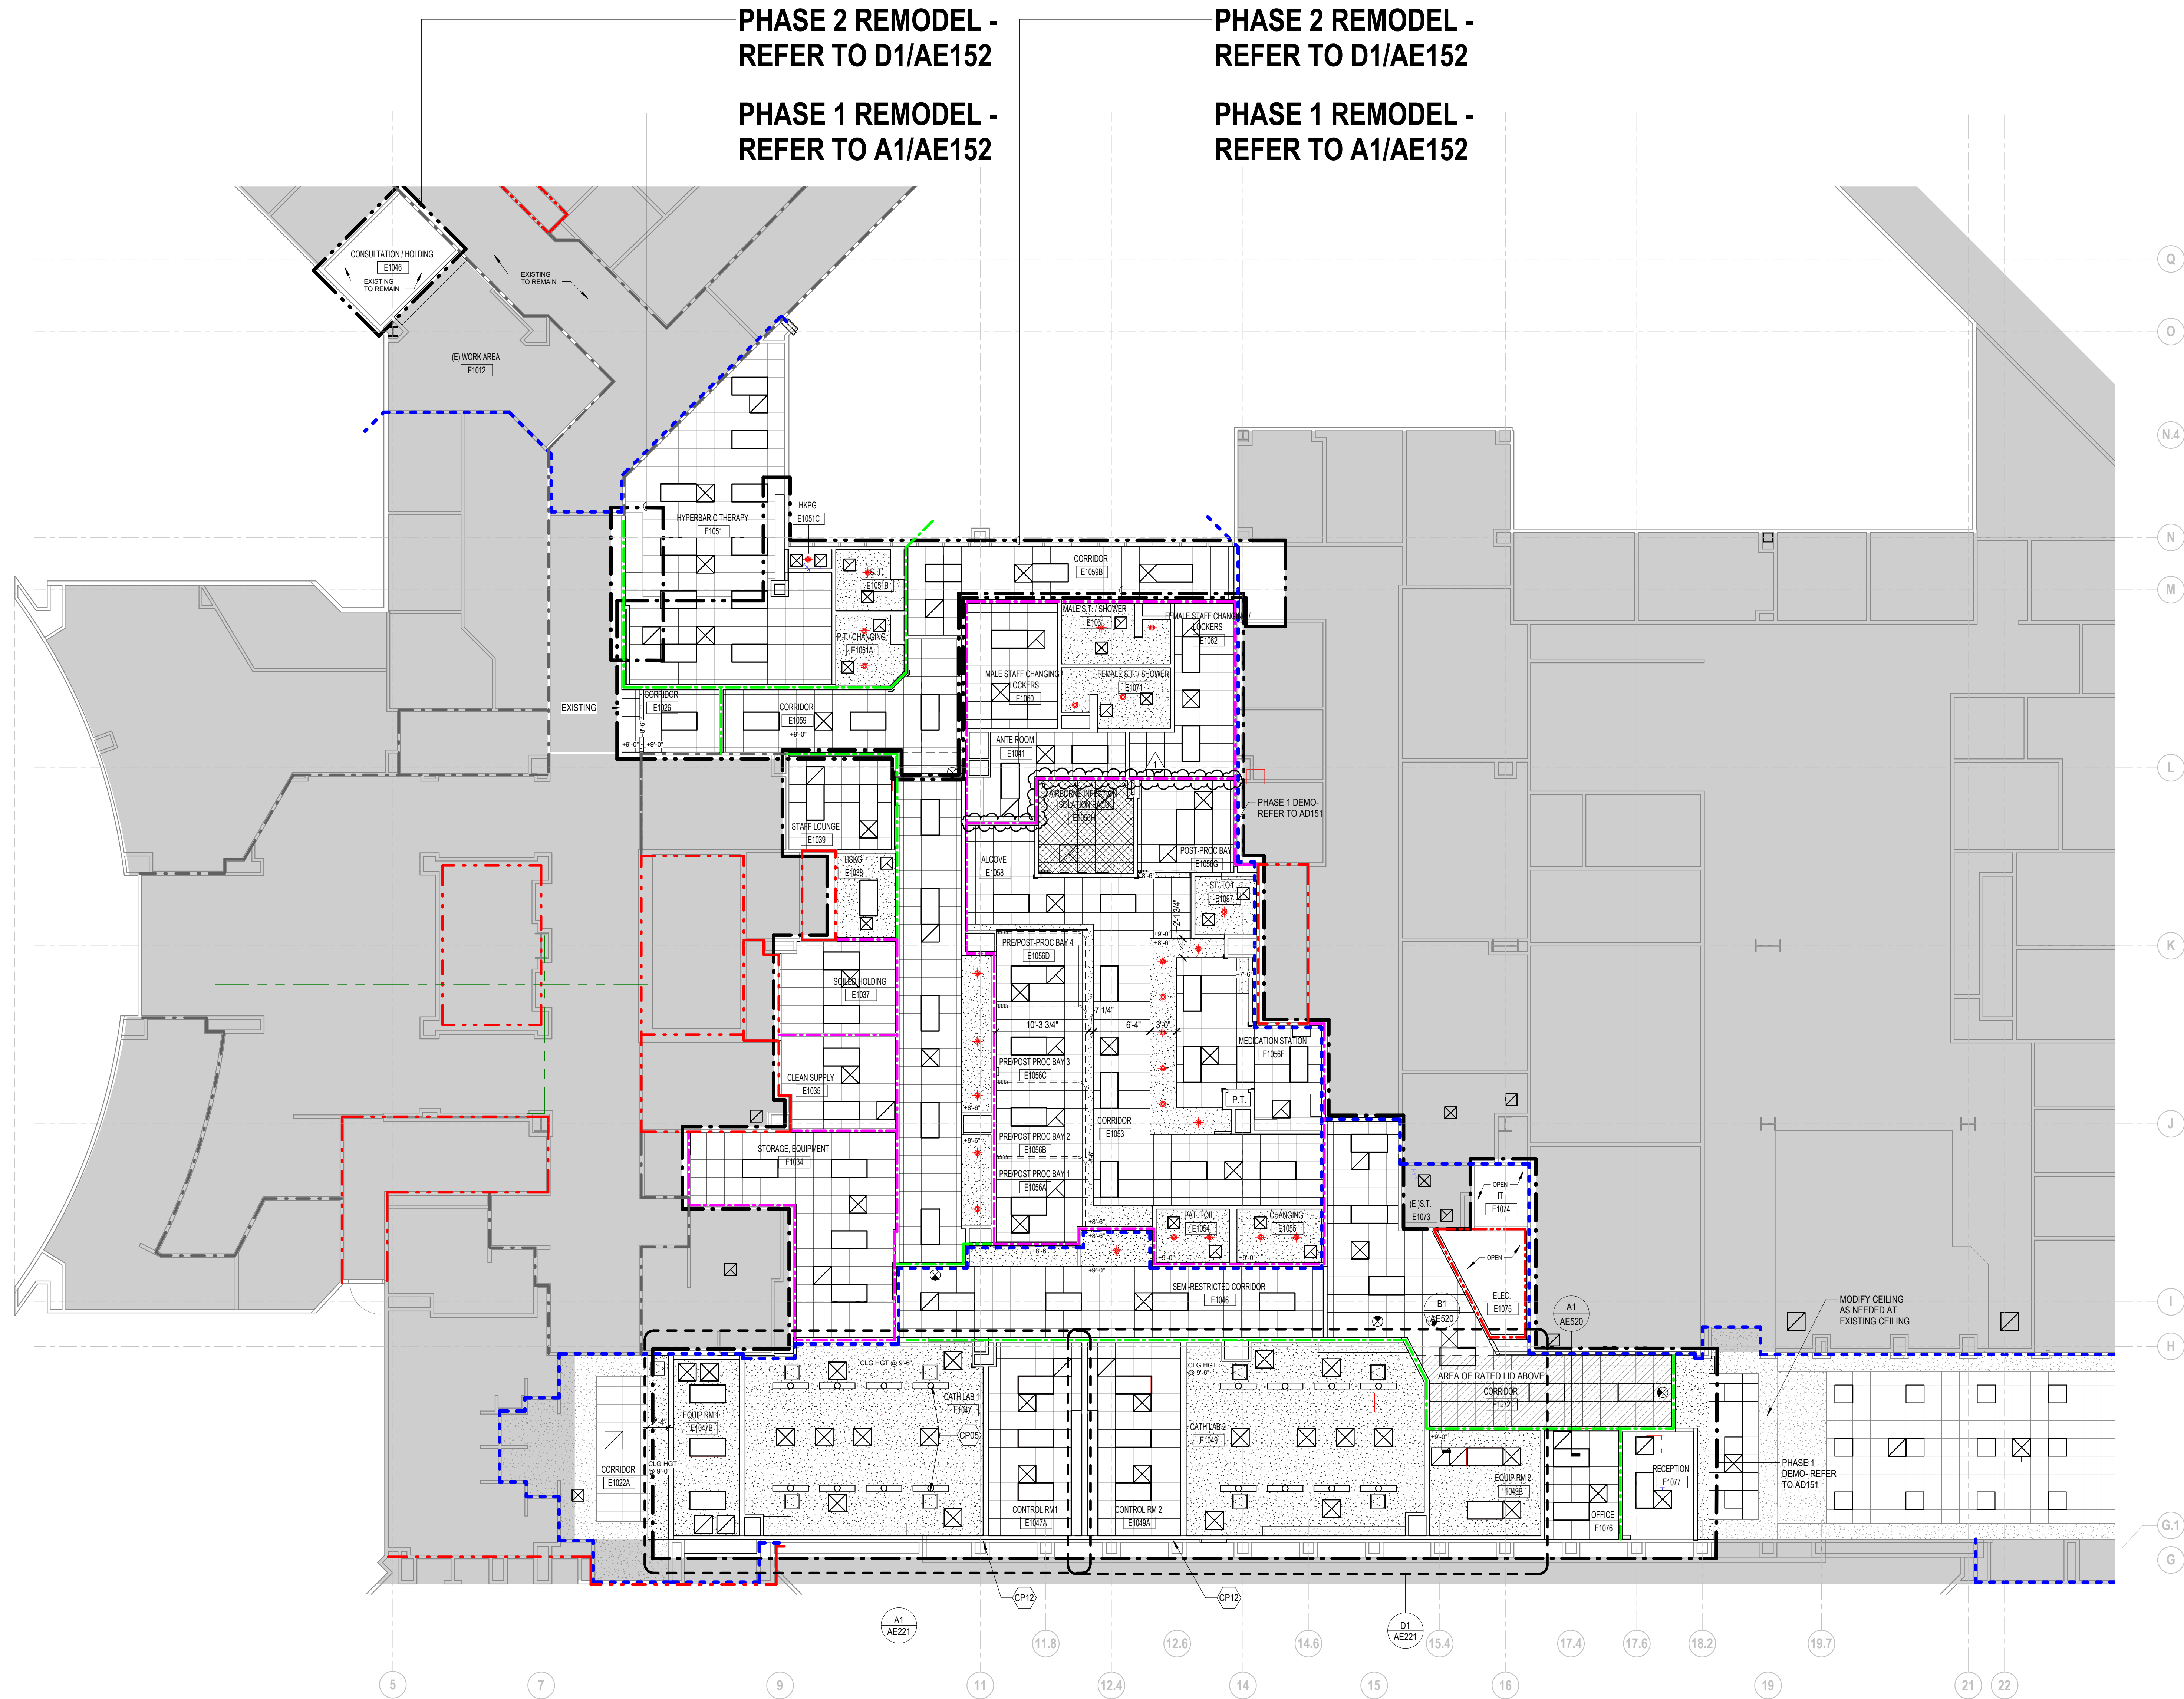

**A1 PARTIAL REFLECTED CEILING PLAN - LEVEL 1 - REMODEL**  
SCALE: 1/8" = 1'-0"

SHEET NOTES



**RIVERSIDE UNIVERSITY  
HEALTH SYSTEM  
MEDICAL CENTER**  
26520 CACTUS AVENUE, MORENO VALLEY,  
CALIFORNIA 92555



550 SOUTH HOPE STREET, SUITE 2700  
LOS ANGELES, CALIFORNIA 90071  
TEL: (213)629-0100 FAX: (213)629-0070

KEY NOTES - CEILING PLAN - REMODEL

- CP05 NEW 18 X 18 ACCESS PANELS. CONFIRM LOCATION PRIOR TO INSTALLATION.  
CP12 WHERE GYPSUM BOXES REMOVED AT EXTERIOR WALL, PATCH AS NEEDED TO MAINTAIN AIR BARRIER AND ALLOW FOR NEW FURRED WALL TO BE CONSTRUCTED. TYPICAL.

ARCHITECT STAMP



CONSULTANT

CONSULTANT STAMP

KEY PLAN

CEILING PLAN LEGEND

- EXISTING LAY-IN TILE GRID CEILING
- NEW LAY-IN TILE GRID CEILING
- NEW LAY-IN TILE GRID CEILING (HATCH INDICATES TUNNEL CORRIDOR AREA)
- NEW LAY-IN TILE GRID CEILING, COMPLIANT FOR USE IN AIRBORNE INFECTION ISOLATION EXAM / PACU ROOM. NON-ABSORBING, NON-PERFORATED, CLEAN AND WASHABLE. LAY-IN TILES SHALL BE GASKETED.
- EXISTING PAINTED GYB. BD. CEILING
- NEW PAINTING GYP. BD. CEILING SEE DETAIL A1 & A4 ON AE519

REVISIONS

NO.	DESCRIPTION	DATE
1	ADDENDUM 01	04/30/2025

FILE LOG

ACTIVITY	BY
Design	Designer
Draw	Author
Check	Checker
Issue Date	2023/05/09

AGENCY APPLICATION NUMBER

**S231455-33-00**

AGENCY APPROVAL STAMP

BUILDING TITLE  
**RIVERSIDE UNIVERSITY HEALTH SYSTEM  
MEDICAL CENTER**

PROJECT TITLE  
**NEW CARDIAC CATHETERIZATION LAB  
SUITE & HYPERBARIC FACILITY EXPANSION**

RUMS/MC PROJ. NO.  
FM08430011869

CONSULTANT PROJ. NO.  
047-10071-002

SHEET NAME

**PARTIAL REFLECTED CEILING  
PLAN - LEVEL 1 - REMODEL**

SHEET NUMBER

**AE121**













5/8/2025 3:11:38 PM Autodesk Docs\\047-10071-002\_RUHS-TO - Riverside County Health\_Cath Lab\_RUHS AND CATH LAB ARCHIT

F  
E  
D  
C  
B  
A

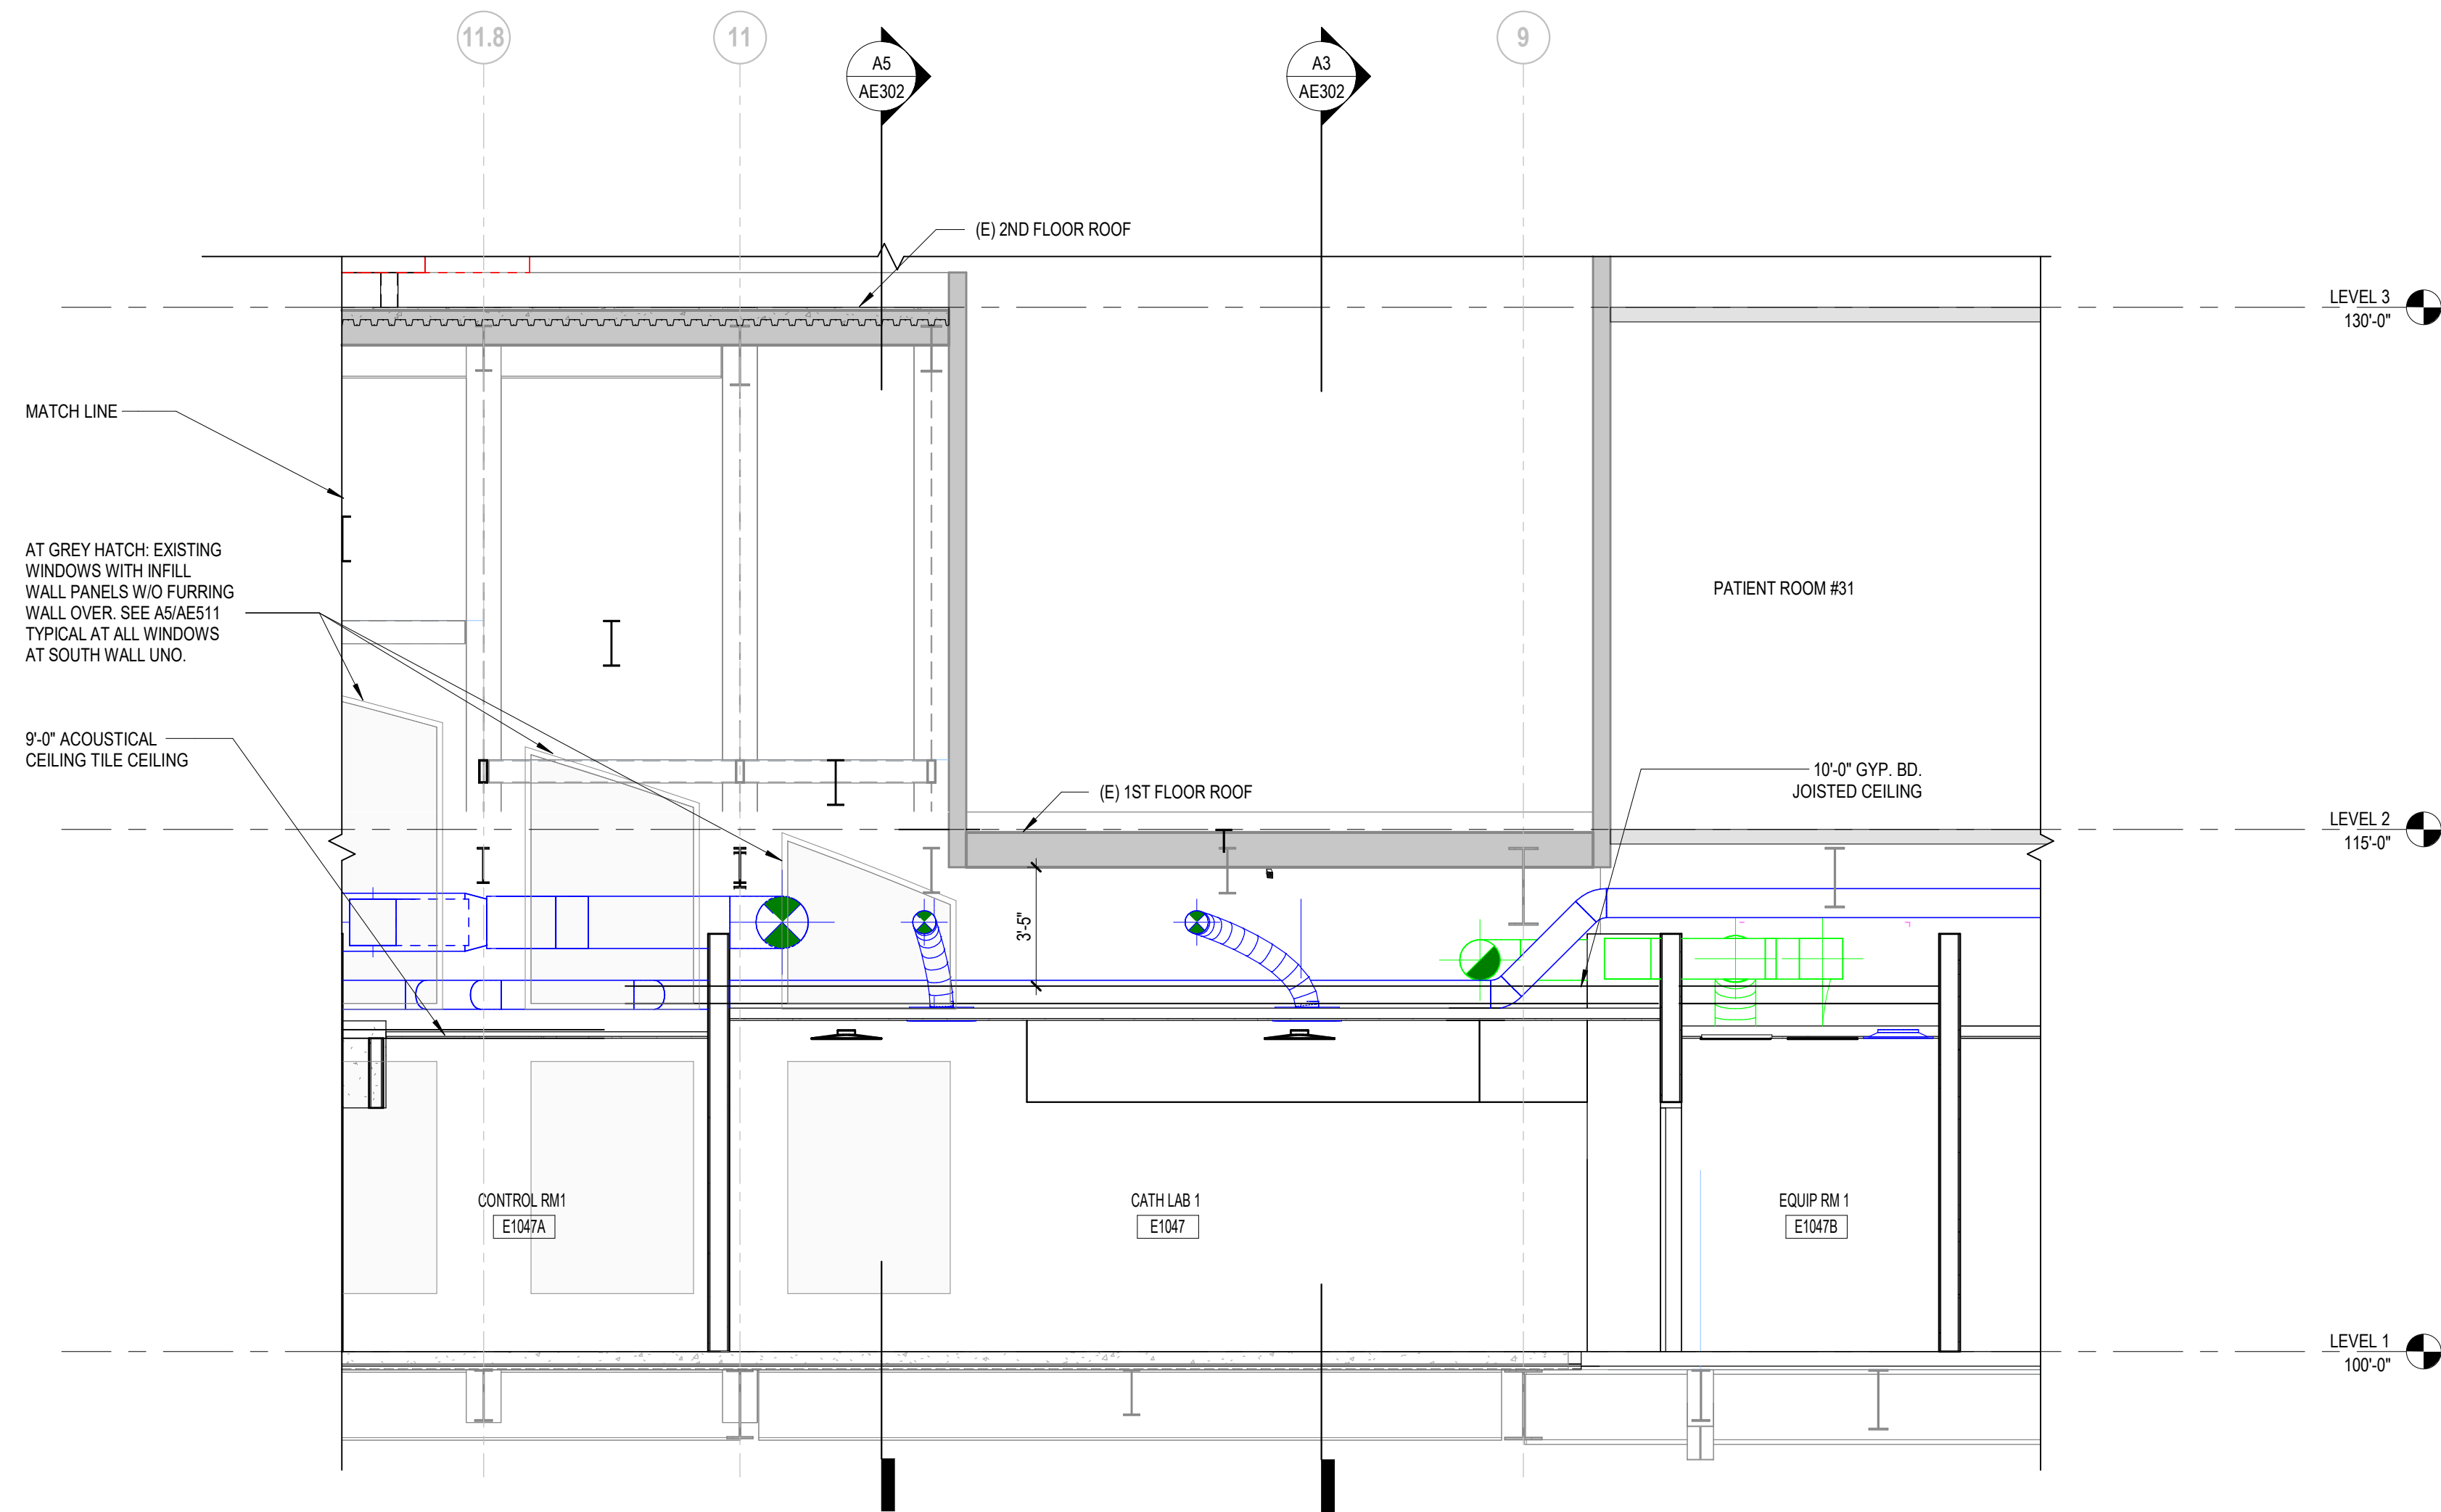

**D1 BUILDING SECTION @ CATH LAB 1 - EAST/WEST**  
SCALE: 1/4" = 1'-0"

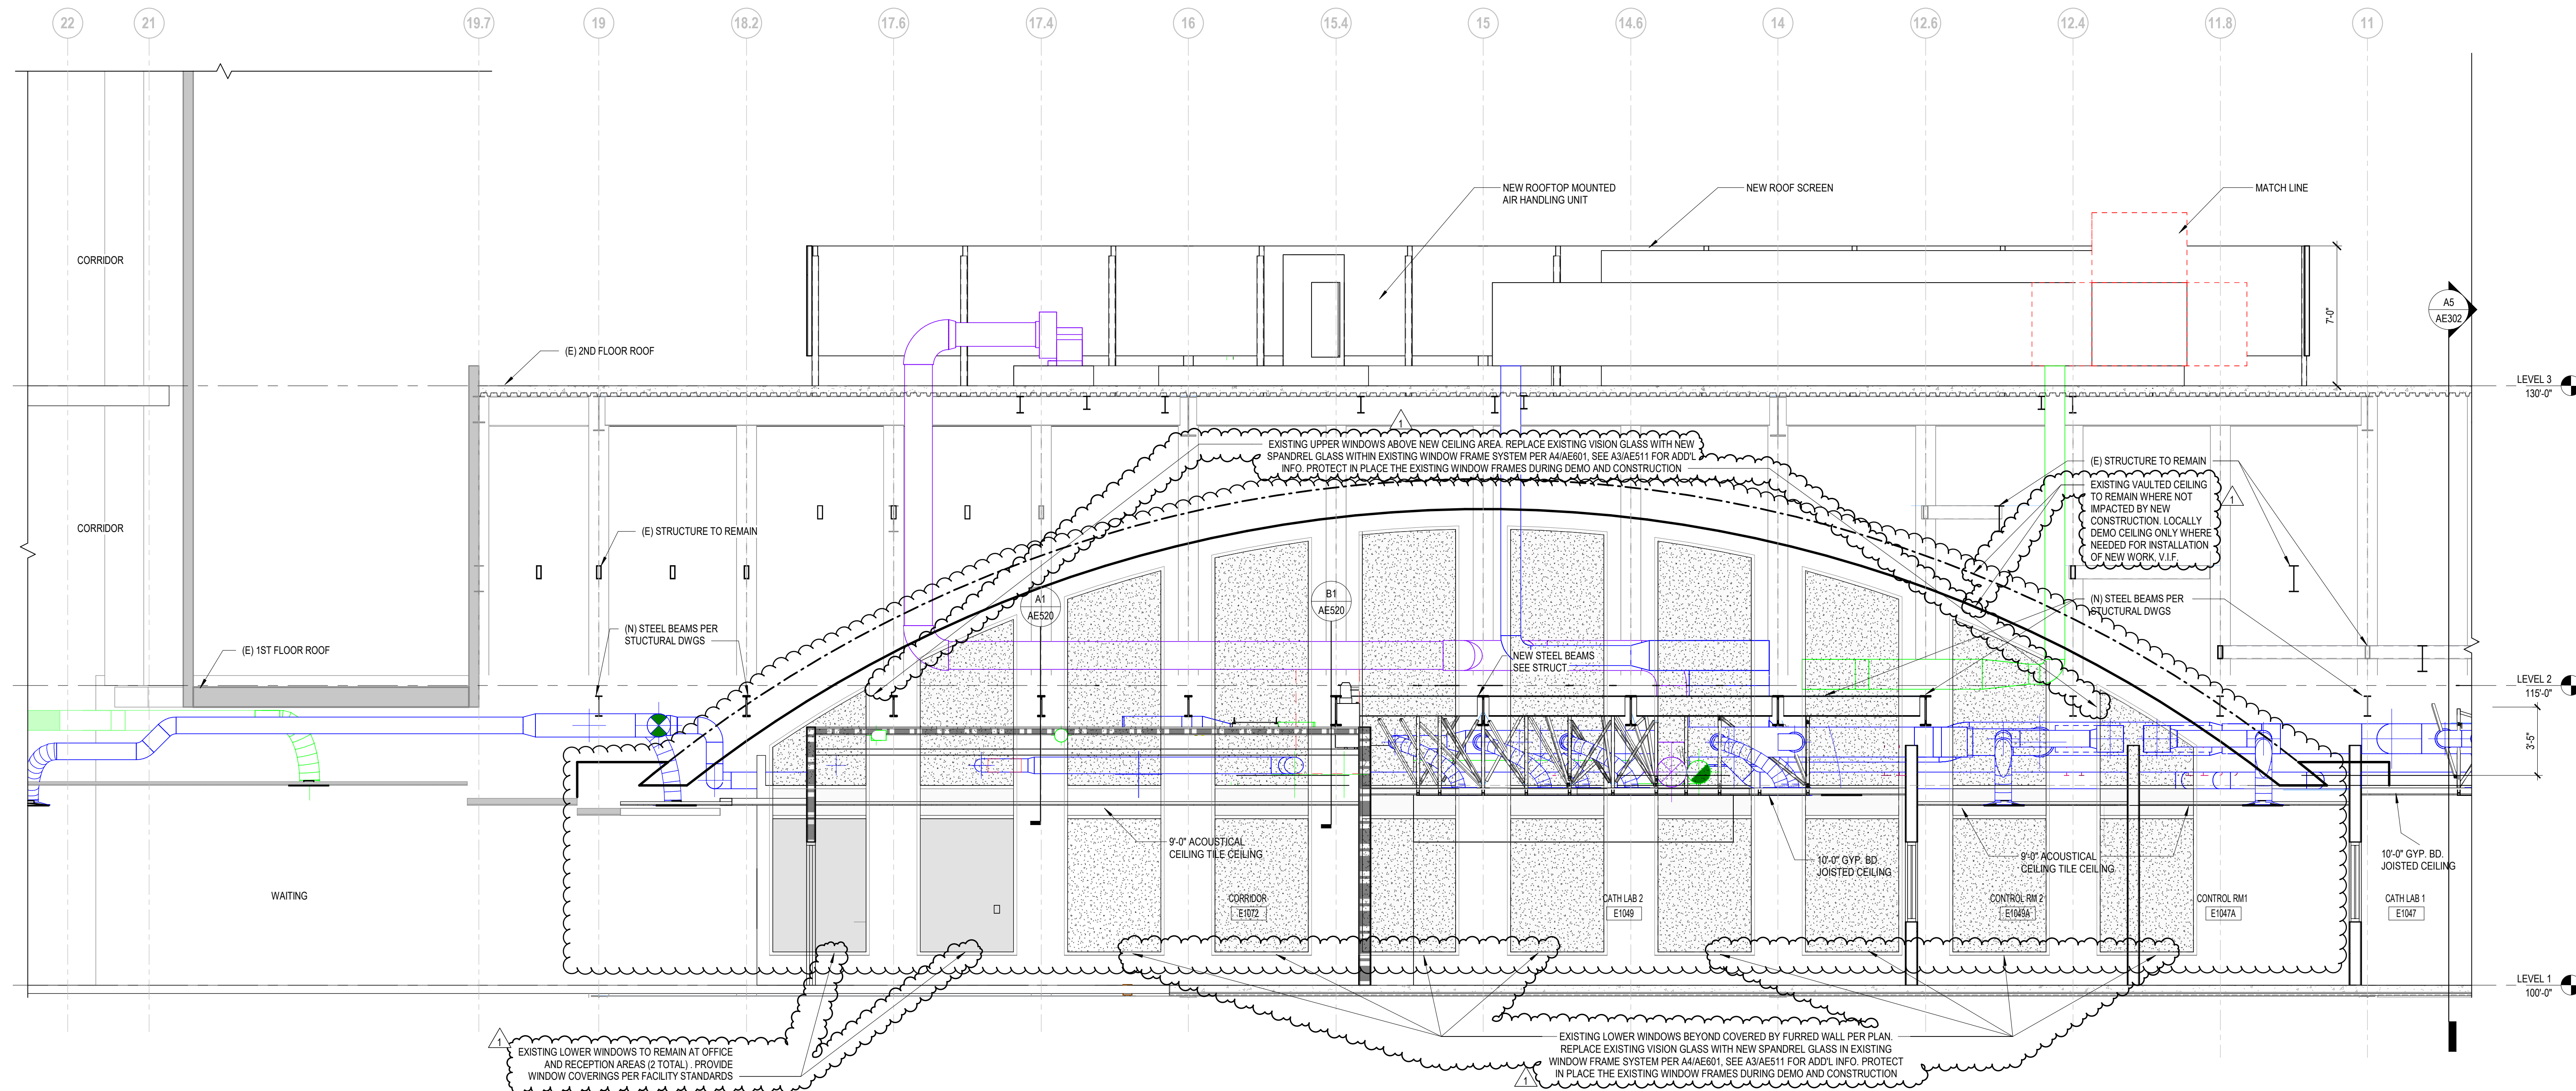

**A1 BUILDING SECTION ELEVATION @ CATH LAB 2 - EAST/WEST**  
SCALE: 1/4" = 1'-0"



RIVERSIDE UNIVERSITY  
HEALTH SYSTEM  
MEDICAL CENTER  
26520 CACTUS AVENUE, MORENO VALLEY,  
CALIFORNIA 92555



550 SOUTH HOPE STREET, SUITE 2700  
LOS ANGELES, CALIFORNIA 90071  
TEL: (213)629-0100 FAX: (213)629-0070

ARCHITECT STAMP



CONSULTANT

CONSULTANT STAMP

KEY PLAN

REVISIONS

NO.	DESCRIPTION	DATE
1	ADDENDUM 01	04/30/2025

FILE LOG

ACTIVITY	BY
Design	Designer
Draw	Author
Check	Checker
Issue Date	20250509

AGENCY APPLICATION NUMBER

**S231455-33-00**

AGENCY APPROVAL STAMP

BUILDING TITLE  
RIVERSIDE UNIVERSITY HEALTH SYSTEM  
MEDICAL CENTER

PROJECT TITLE  
NEW CARDIAC CATHETERIZATION LAB  
SUITE & HYPERBARIC FACILITY EXPANSION

RUHS-MC PROJ. NO.  
FM08430011869

CONSULTANT PROJ. NO.  
047-10071-002

SHEET NAME

**PARTIAL BUILDING SECTION  
@ CATH LAB - EAST/WEST**

SHEET NUMBER

**AE301**



5/20/2023 3:11:40 PM Autodesk Docs\\047-10071-002 Riverside County Health Center Lab RUMS and Cath Lab ARCH\\CHT

A

B


D

E

F

## C1 PARTITION TYPES STUD (PLANS)

SCALE: NTS

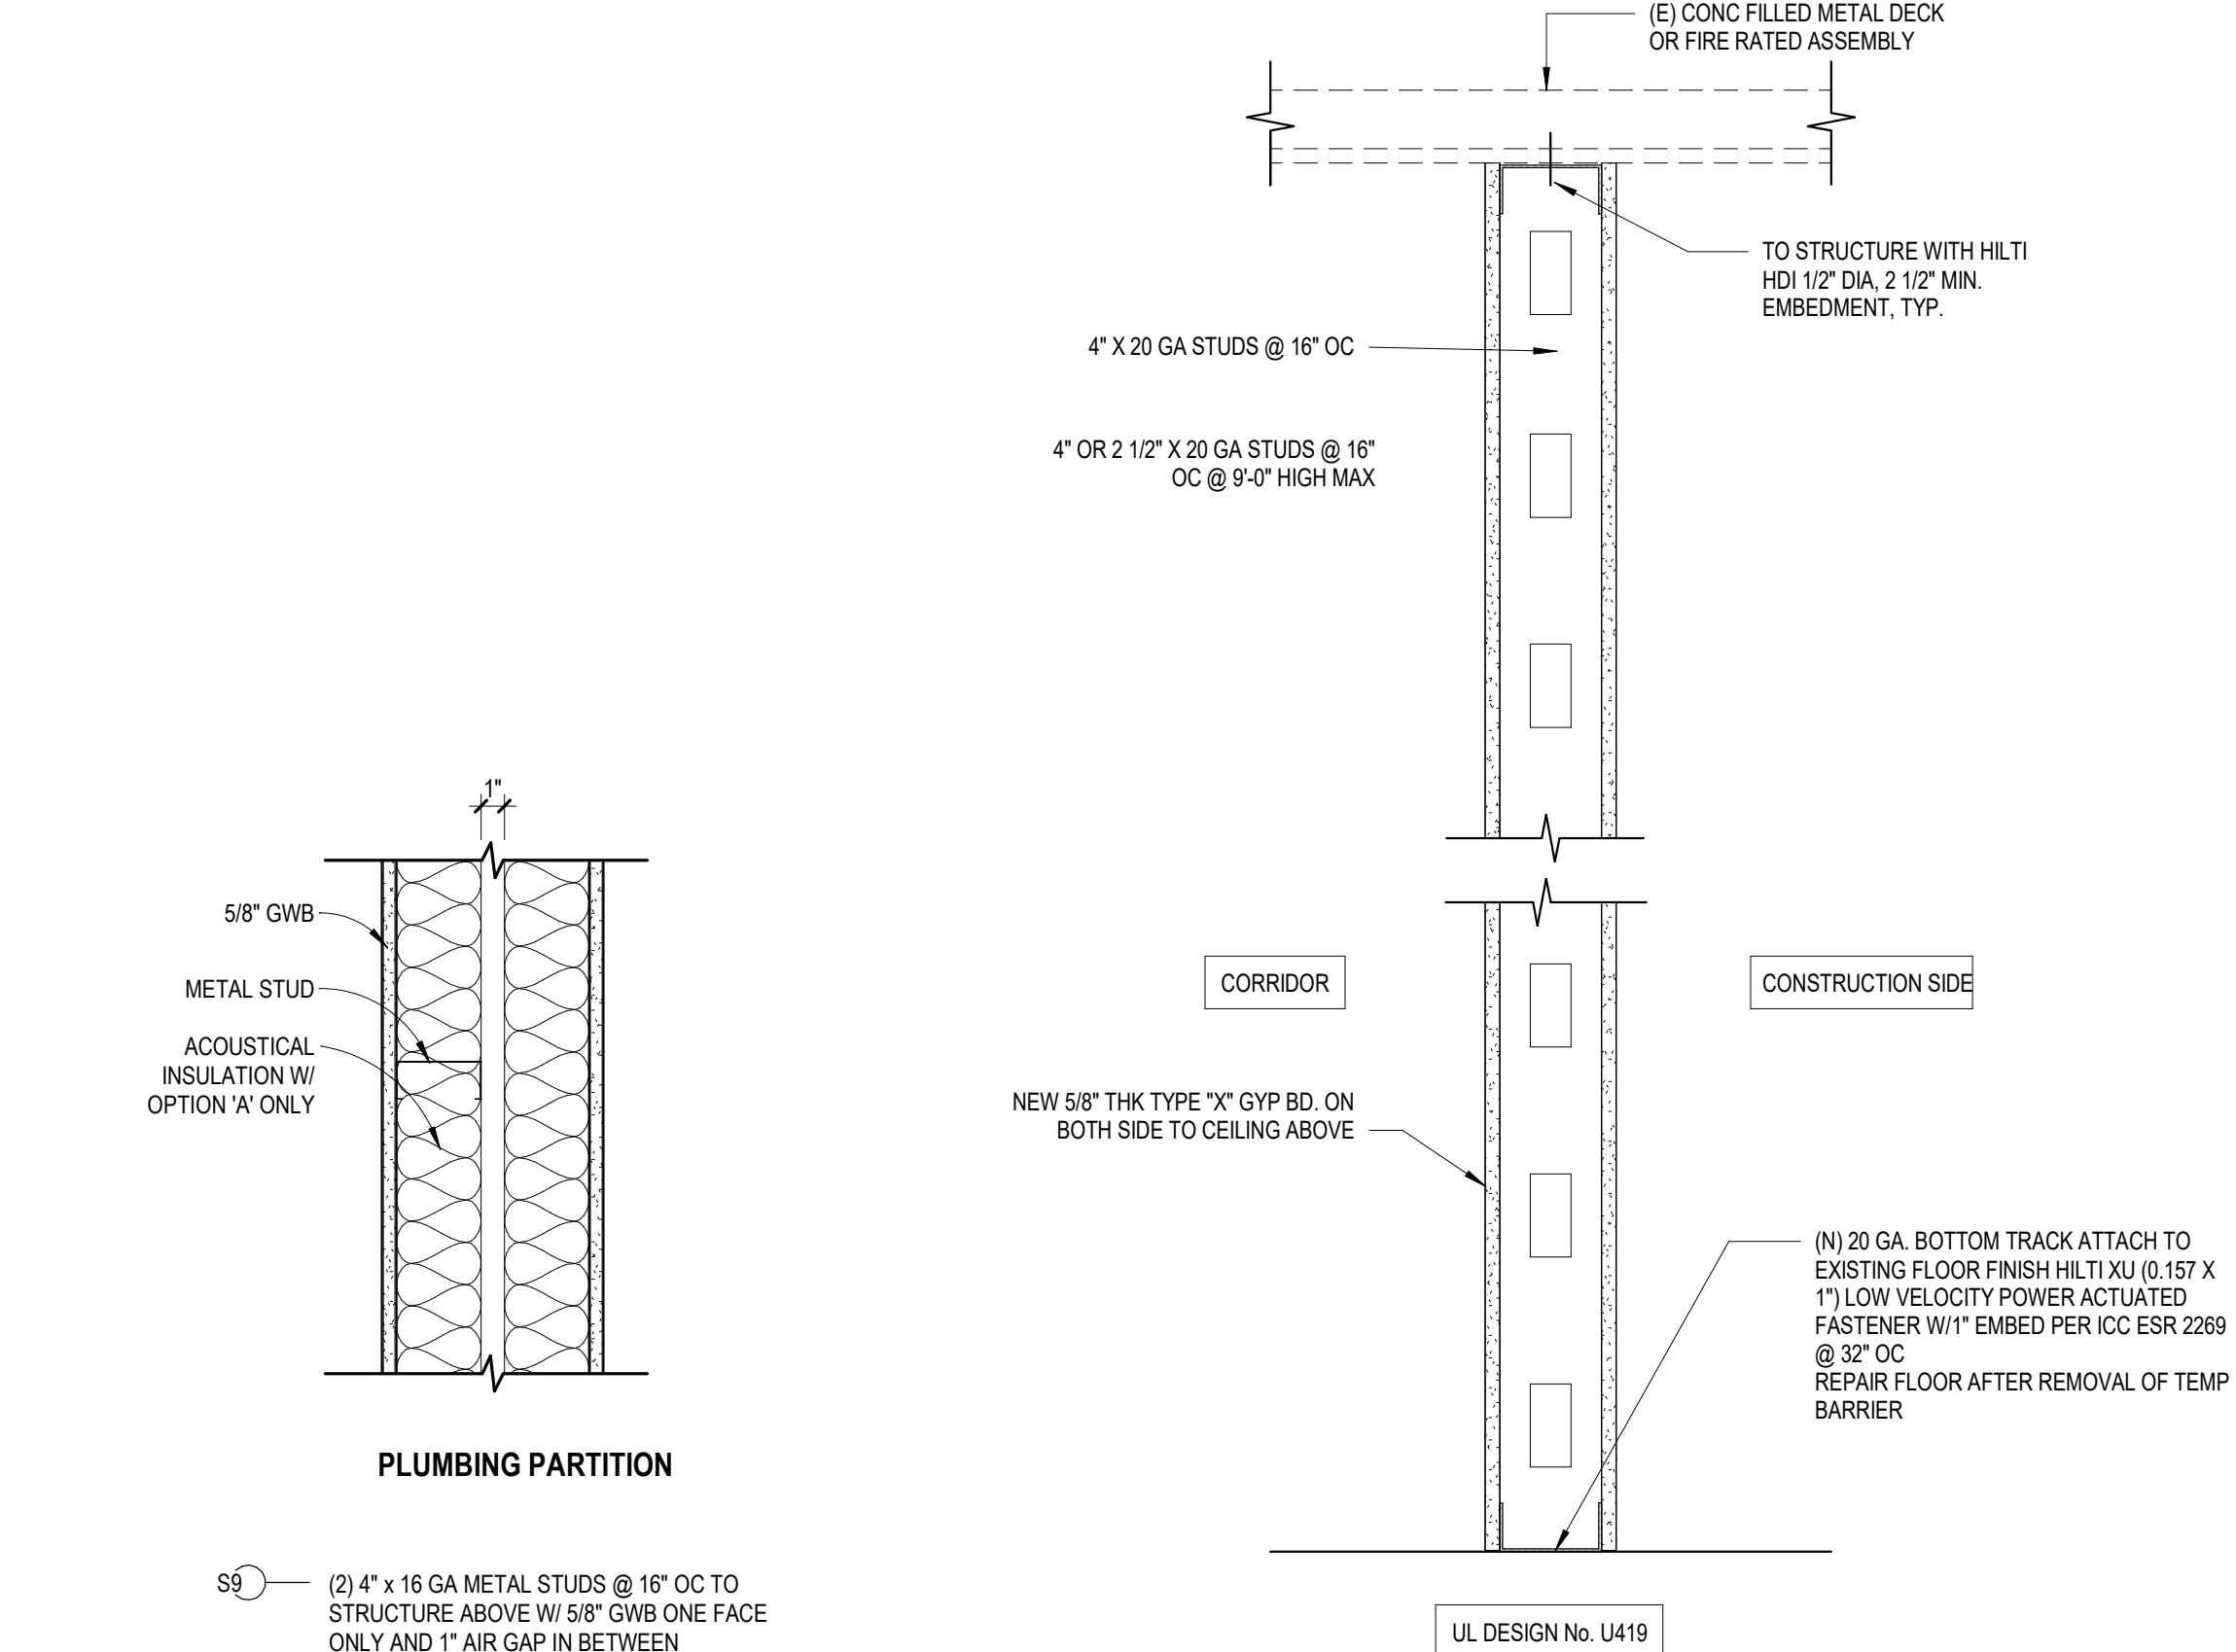

## A1 PARTITION TYPES STUD (PLUMBING)

SCALE: 1 1/2" = 1'-0"

## A2 TEMPORARY CONSTRUCTION BARRIER

SCALE: 1 1/2" = 1'-0"

## GENERAL NOTES:

- PROVIDE MINIMUM 0.0312" STUDS @ WALLS TO RECEIVE FINISH (TILE, STONE, WOOD, ETC).
- PROVIDE MINIMUM 0.0312" STUDS @ JAMBS OF DOOR AND FIXED GLASS FRAMES, @ OPEN PARTITION ENDS, AND WHERE PARTITION IS TO RECEIVE WALL MOUNTED SHELVES, CASEWORK, PLUMBING FIXTURES, ETC.
- USE 5/8" FR GWB @ ALL FIRE-RATED PARTITIONS, ANCHOR W/ SCREWS @ 8" OC ON EDGES @ 12" OC IN FIELD PER UL DESIGN NUMBERS LISTED.
- SEE ALL SPECIFICATIONS FOR GWB REQUIREMENTS @ TOILETS AND ALL WET AREAS.
- APPLIES TO POWER AND COMMUNICATIONS, ETC.
- DEPTH OF OUTLET BOX TO BE COMPATIBLE WITH STUD SIZES IN ORDER TO ACCOMMODATE BOX PAD.
- PLUG ALL UNUSED KNOCK-OUTS IN OUTLET BOXES WITH KNOCK-OUT CAPS.
- PROVIDE HILTI FIRESTOP PUTTY PAD OR EQUAL TO OUTLET BOXES IN FIRE-RATED WALLS OR WHERE OTHERWISE INDICATED.
- DEPTH OF OUTLET BOX TO BE COMPATIBLE WITH STUD SIZES IN ORDER TO ACCOMMODATE BOX PAD.
- PROVIDE 2" x 8" FIRE TREATED WOOD BLOCKING @ WALL HUNG CASEWORK, SHELVES, COUNTERTOPS, HEAVY WALL SCONES, AND MAJOR ARTWORK.
- NOTE: THE DIAGONAL BRACING COLUMN INDICATES THAT THE CONTRACTOR HAS AN OPTION TO PROVIDE BRACING TO REDUCE THE VERTICAL SPANS OF STUDS IN ORDER TO MINIMIZE SIZE, GAGE OR SPACING, PROVIDED THAT DOING SO DOESN'T CONFLICT WITH ARCHITECT'S DESIGN CRITERIA.
- FOR FIRE-RESISTIVE JOINT SYSTEMS AND THRU-PENETRATION FIRE STOP SYSTEMS, REFER TO DETAILS AND UL LISTINGS IDENTIFIED ON SHEET AES1 THRU AES3.










## INTERIOR STUD CHART NOTES:

- \* REFERENCE STEEL STUD MANUFACTURER ASSOCIATION'S STANDARDS FOR SECTION PROPERTIES AND DESIGN OF STUD SIZE LISTED HERE.
- USE L/240 DEFLECTION CHART FOR ALL AREAS UNLESS OTHERWISE NOTED.

## PARTITION TYPES GENERAL NOTES & SPACING CHART

INTERIOR STUD GAGE AND SPACING CHART*						
STUD WIDTH	DESIGN THICKNESS (GAGE)	STUD SPACING (INCHES)	PARTITION HEIGHT			BRACING SPACING WHERE OCCURS
			L/120	L/240	L/360	
1 5/8"	0.0175" (25)	16"	10'-7"	8'-4"	-	4'-0" OC
		24"	9'-9"	7'-11"	-	4'-0" OC
	0.0312" (20)	16"	12'-1"	9'-8"	8'-5"	4'-0" OC
		24"	11'-0"	9'-9"	7'-9"	4'-0" OC
2 1/2"	0.0175" (25)	16"	13'-3"	11'-3"	9'-10"	6'-0" OC
		24"	11'-10"	10'-7"	9'-3"	6'-0" OC
	0.0312" (20)	16"	16'-5"	12'-10"	11'-2"	6'-0" OC
		24"	14'-10"	11'-7"	10'-0"	6'-0" OC
4"	0.0175" (25)	16"	17'-2"	15'-4"	13'-4"	8'-0" OC
		24"	15'-1"	14'-2"	12'-4"	8'-0" OC
	0.0312" (20)	16"	23'-1"	18'-4"	15'-11"	8'-0" OC
		24"	20'-9"	16'-5"	14'-3"	8'-0" OC
6"	0.0175" (25)	16"	19'-9"	19'-9"	17'-11"	10'-0" OC
		24"	16'-9"	16'-9"	16'-9"	10'-0" OC
	0.0312" (20)	16"	30'-10"	24'-6"	21'-4"	10'-0" OC
		24"	27'-2"	21'-7"	18'-10"	10'-0" OC

## PARTITION TYPES LEGEND

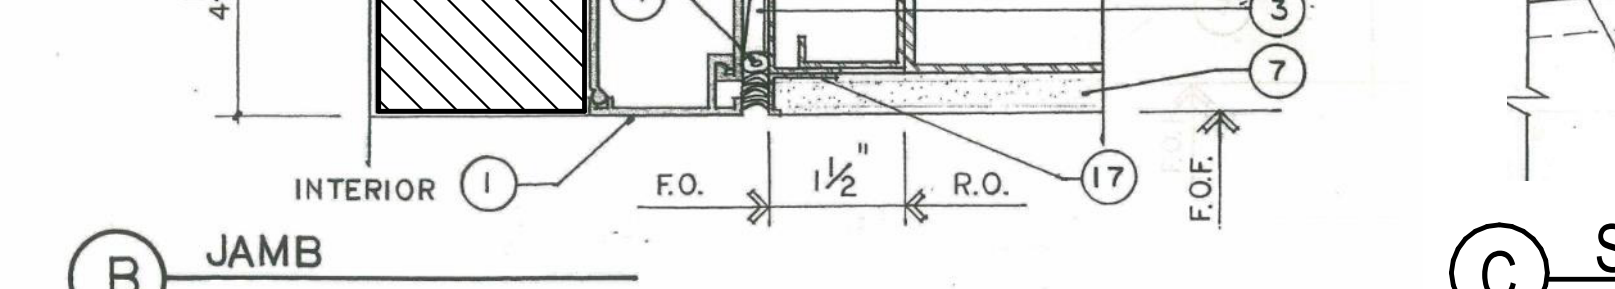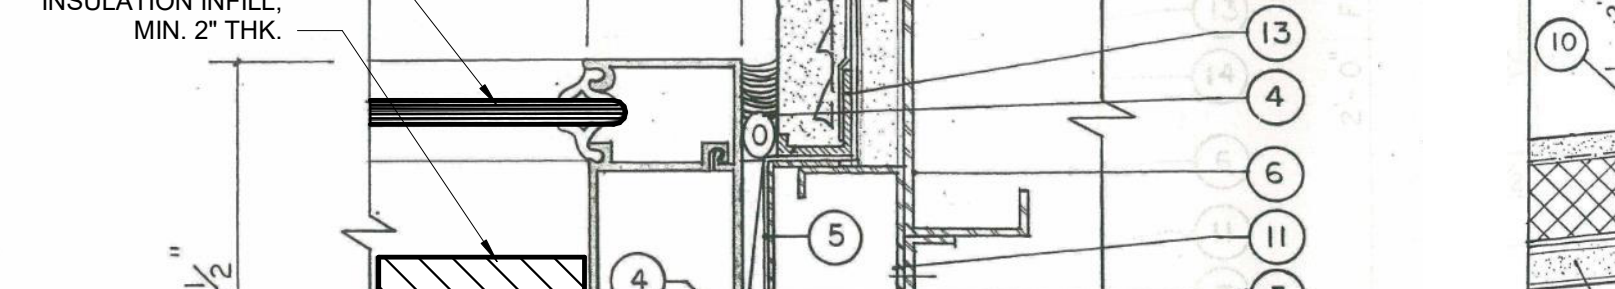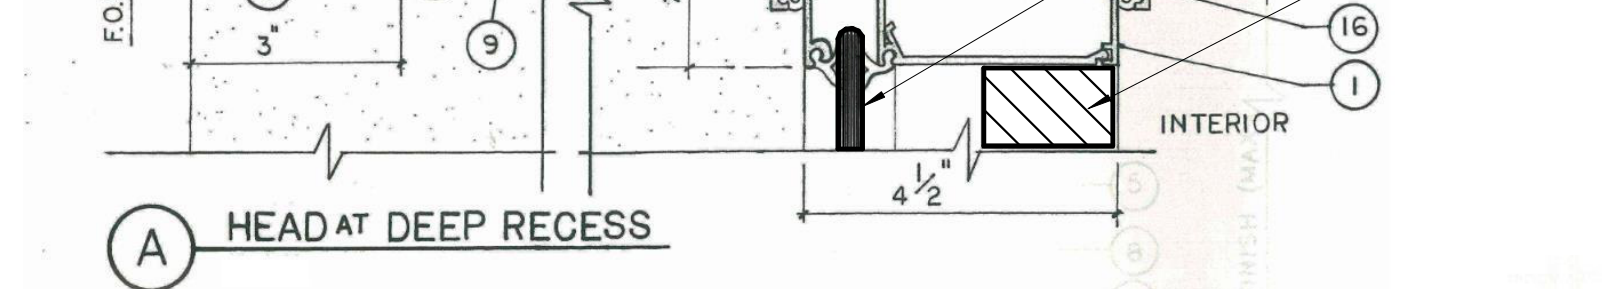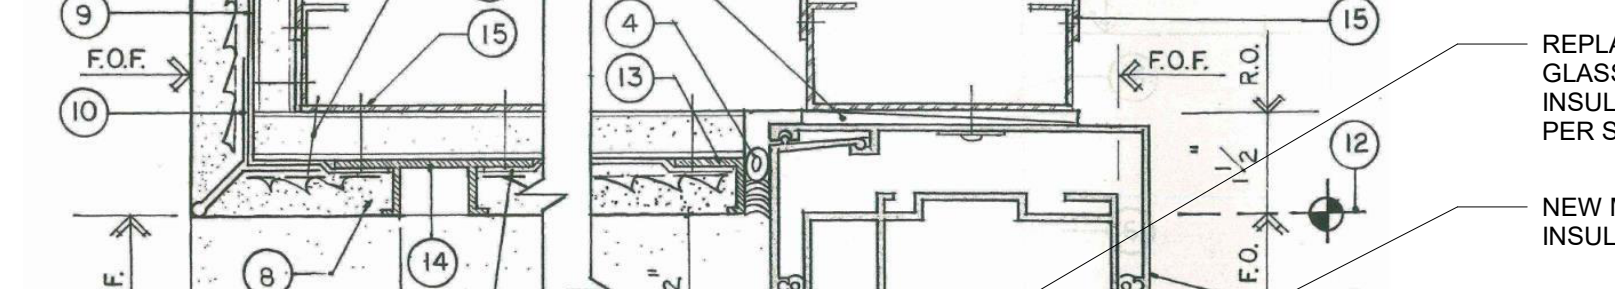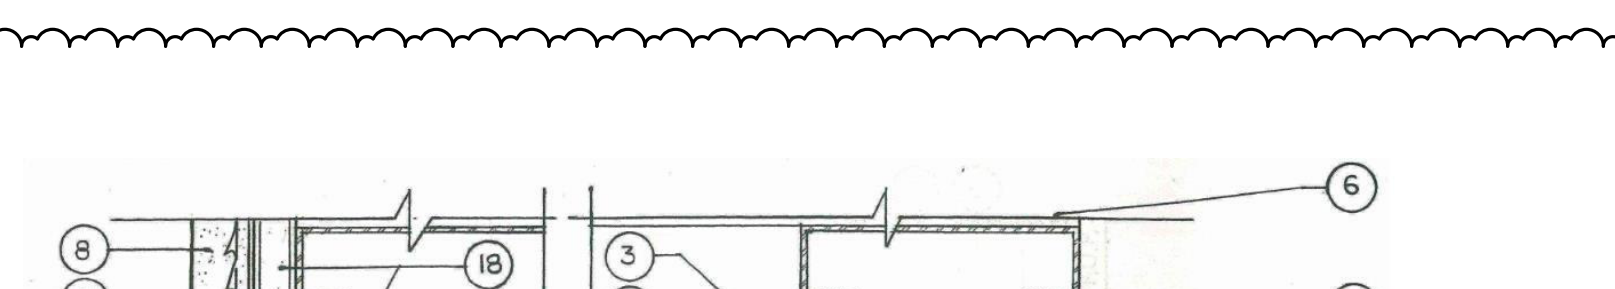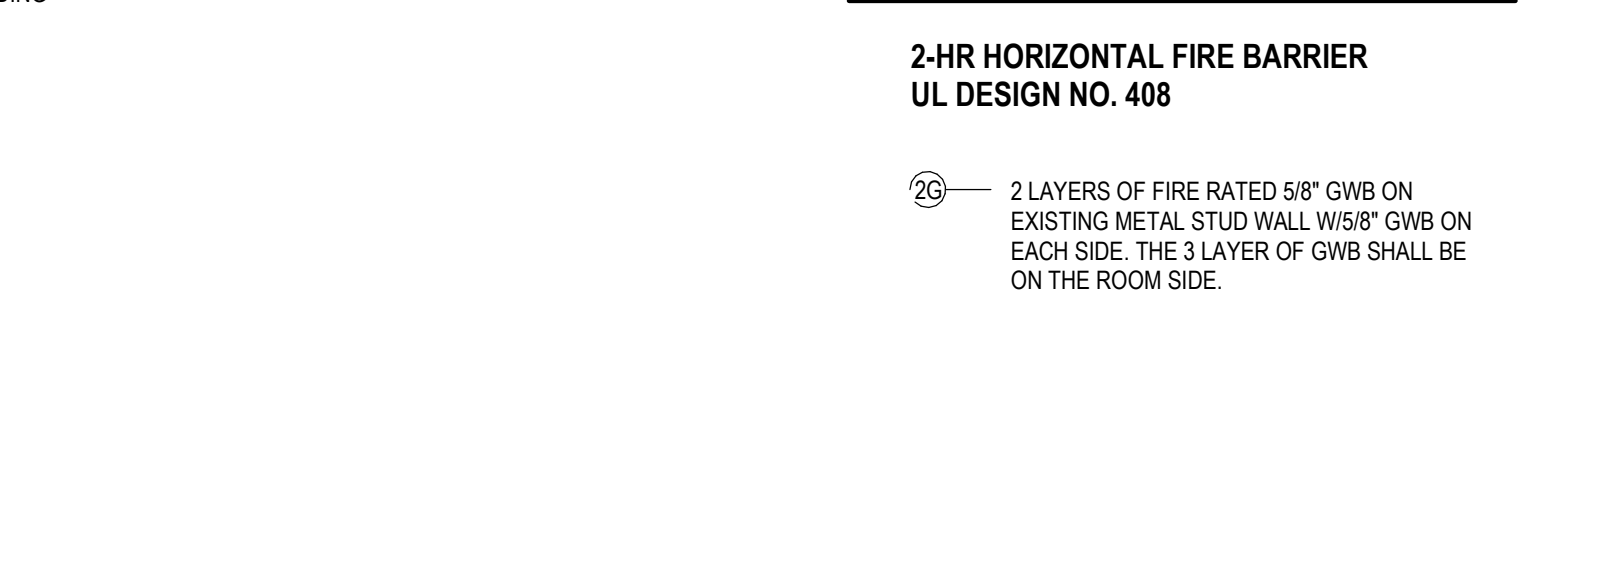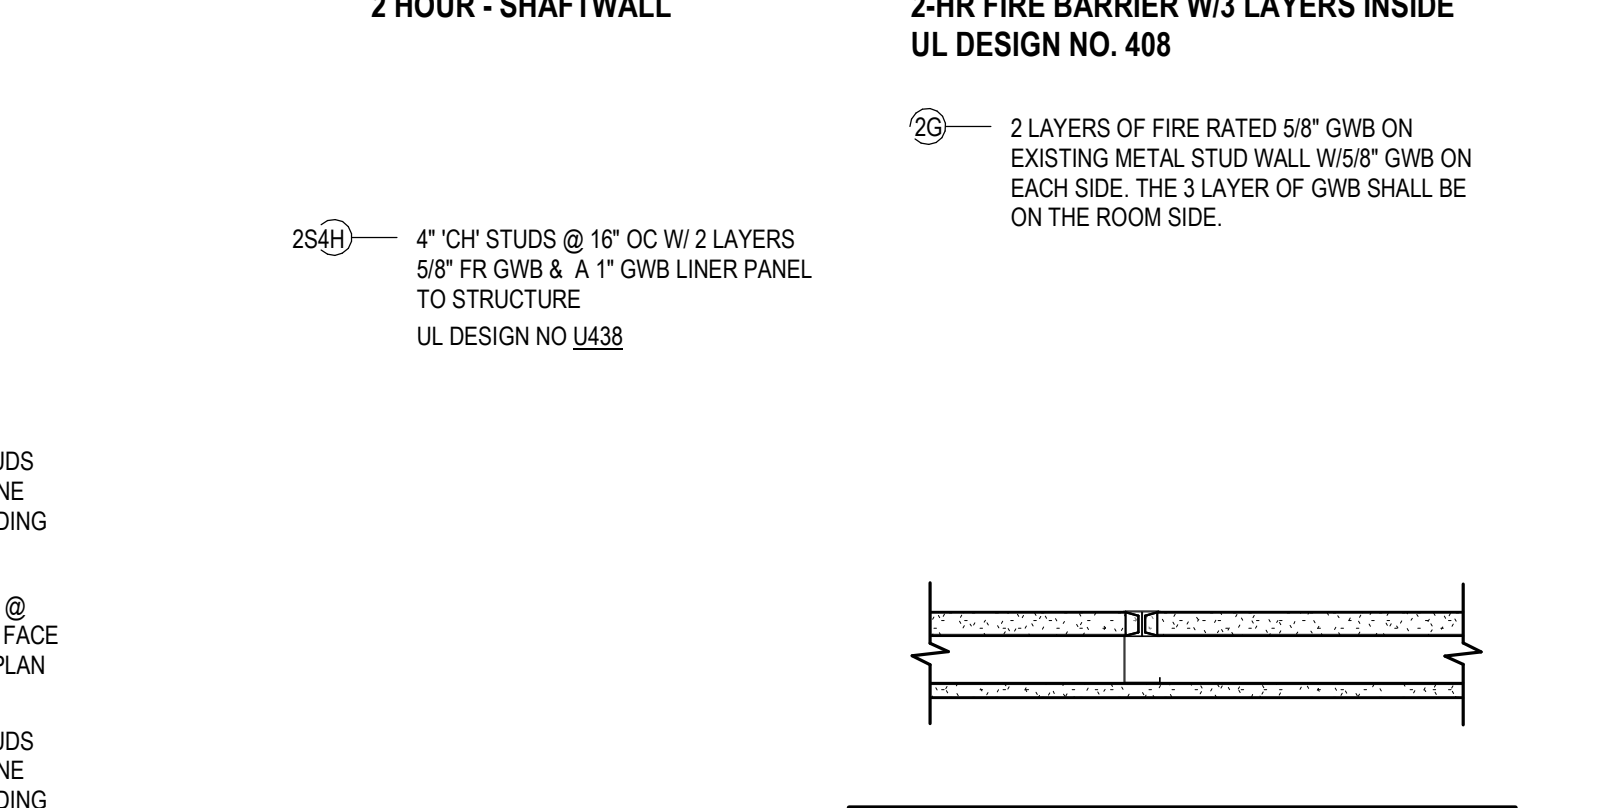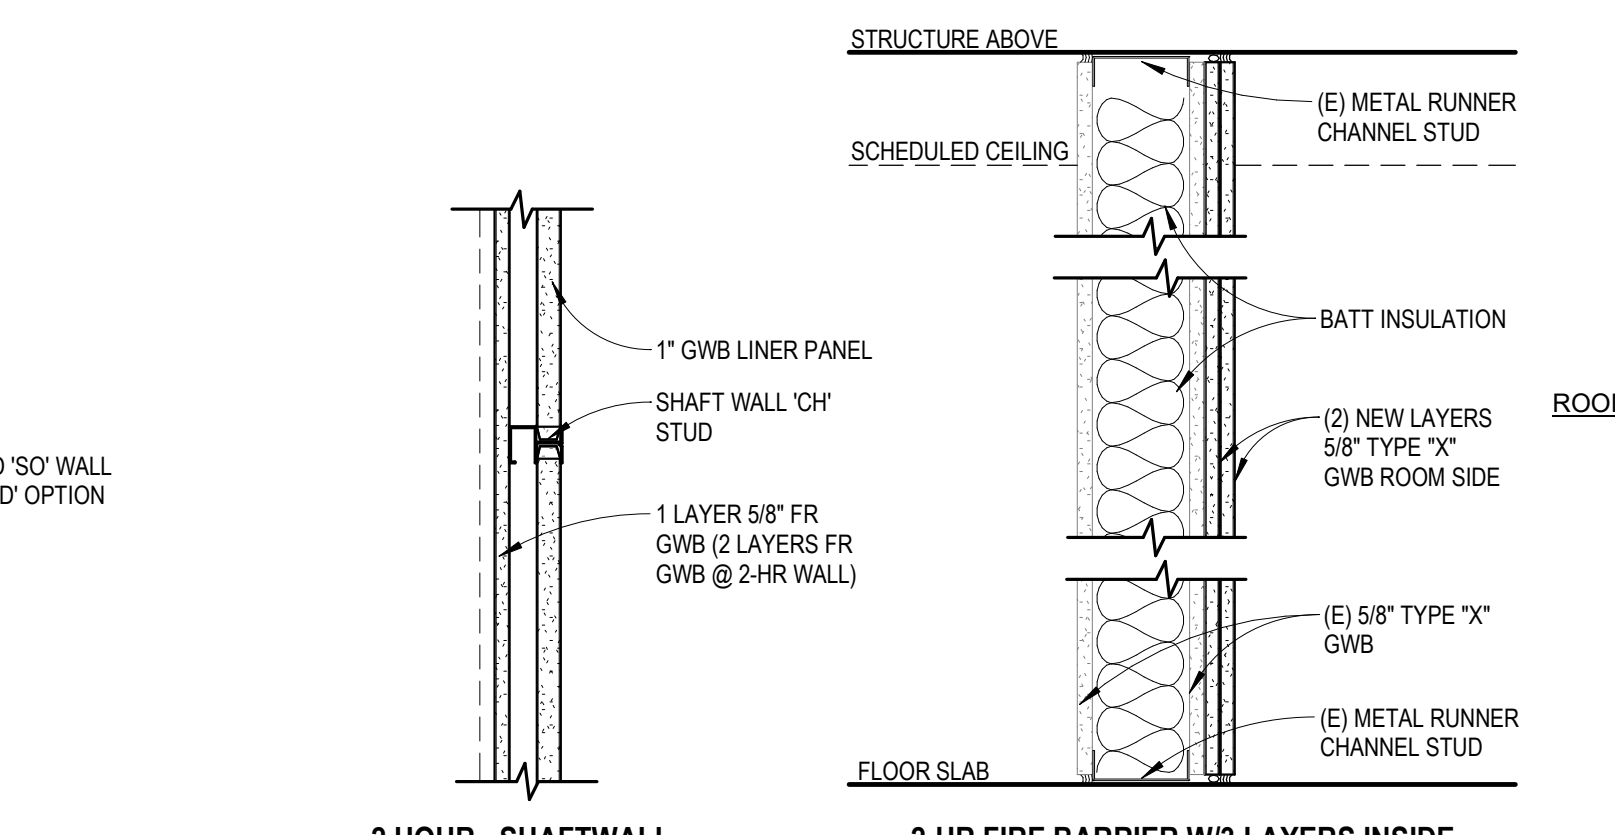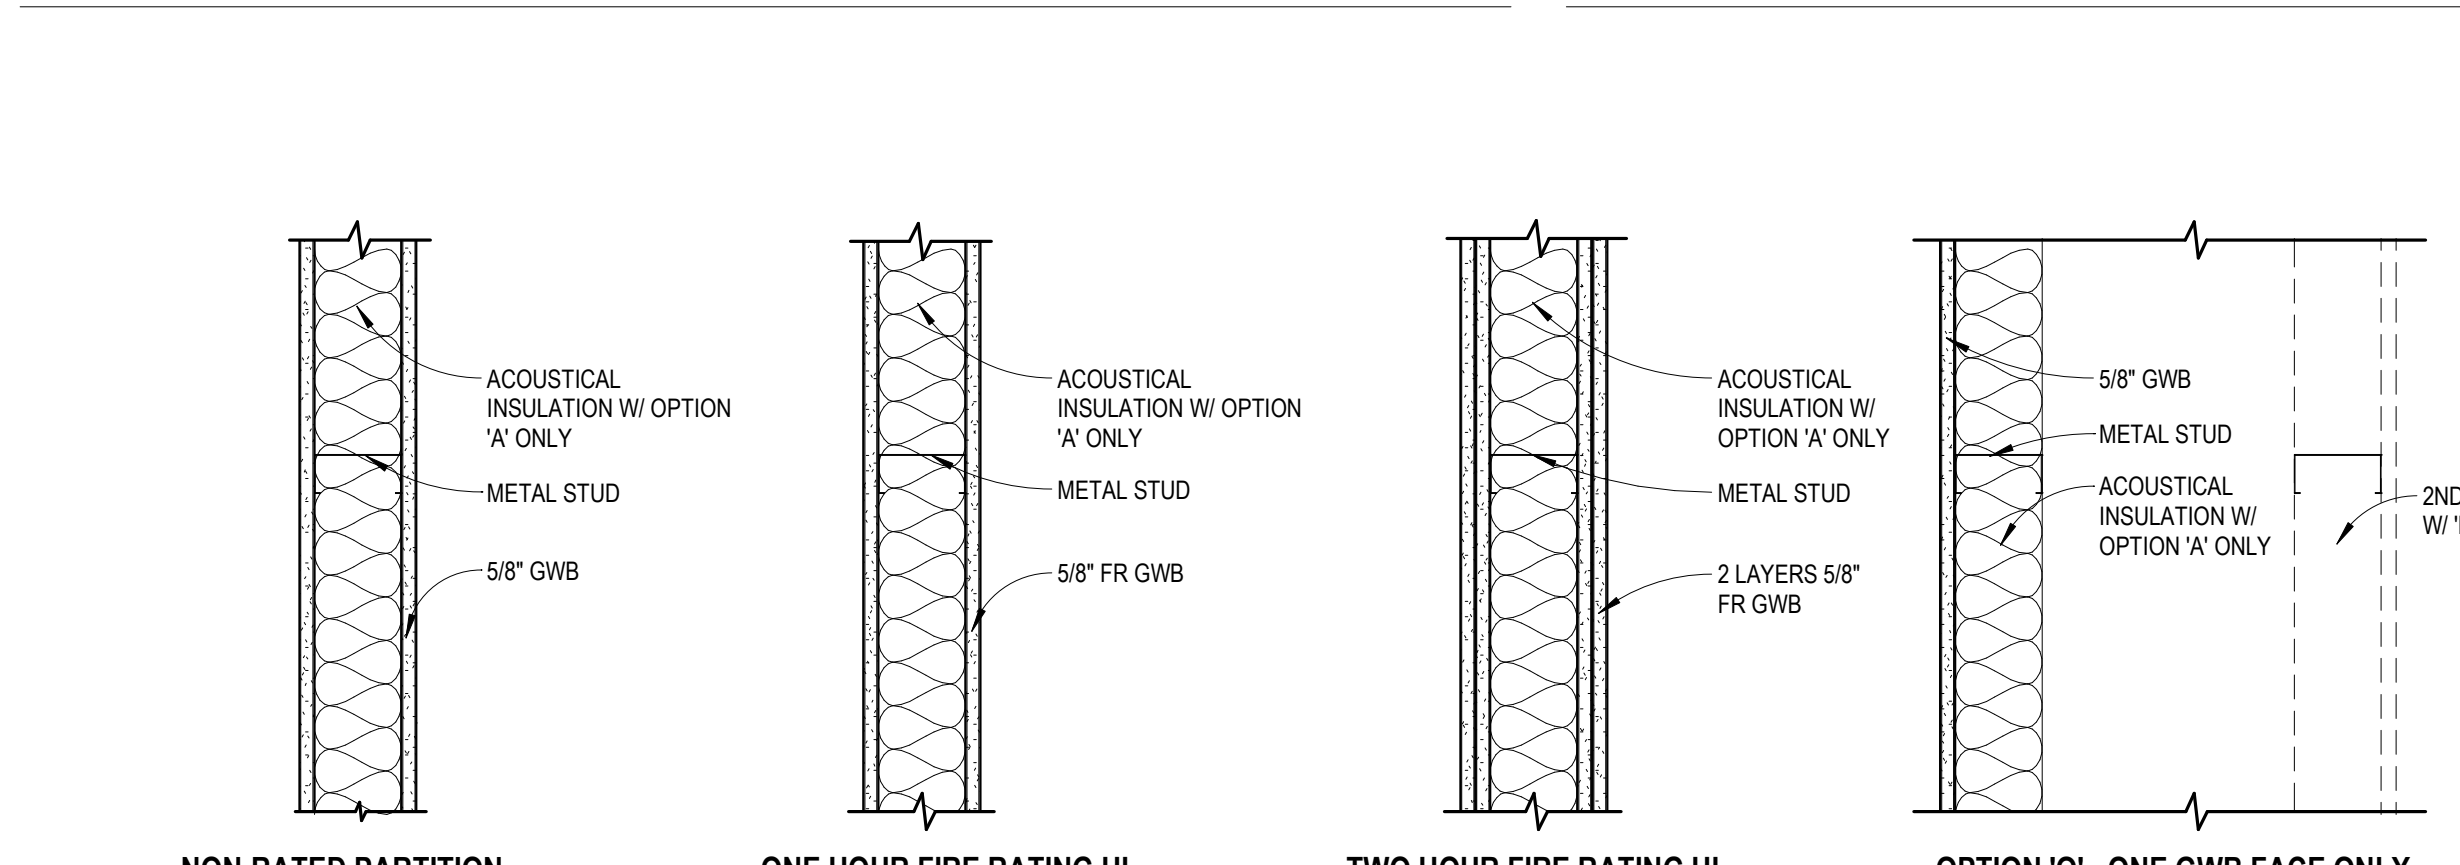


## A3 WINDOW DETAIL - JAMB AT DEEP RECESS

SCALE: NTS


## C5 1-HR RATED ASSEMBLY - HEAD AND SILL

SCALE: 3" = 1'-0"

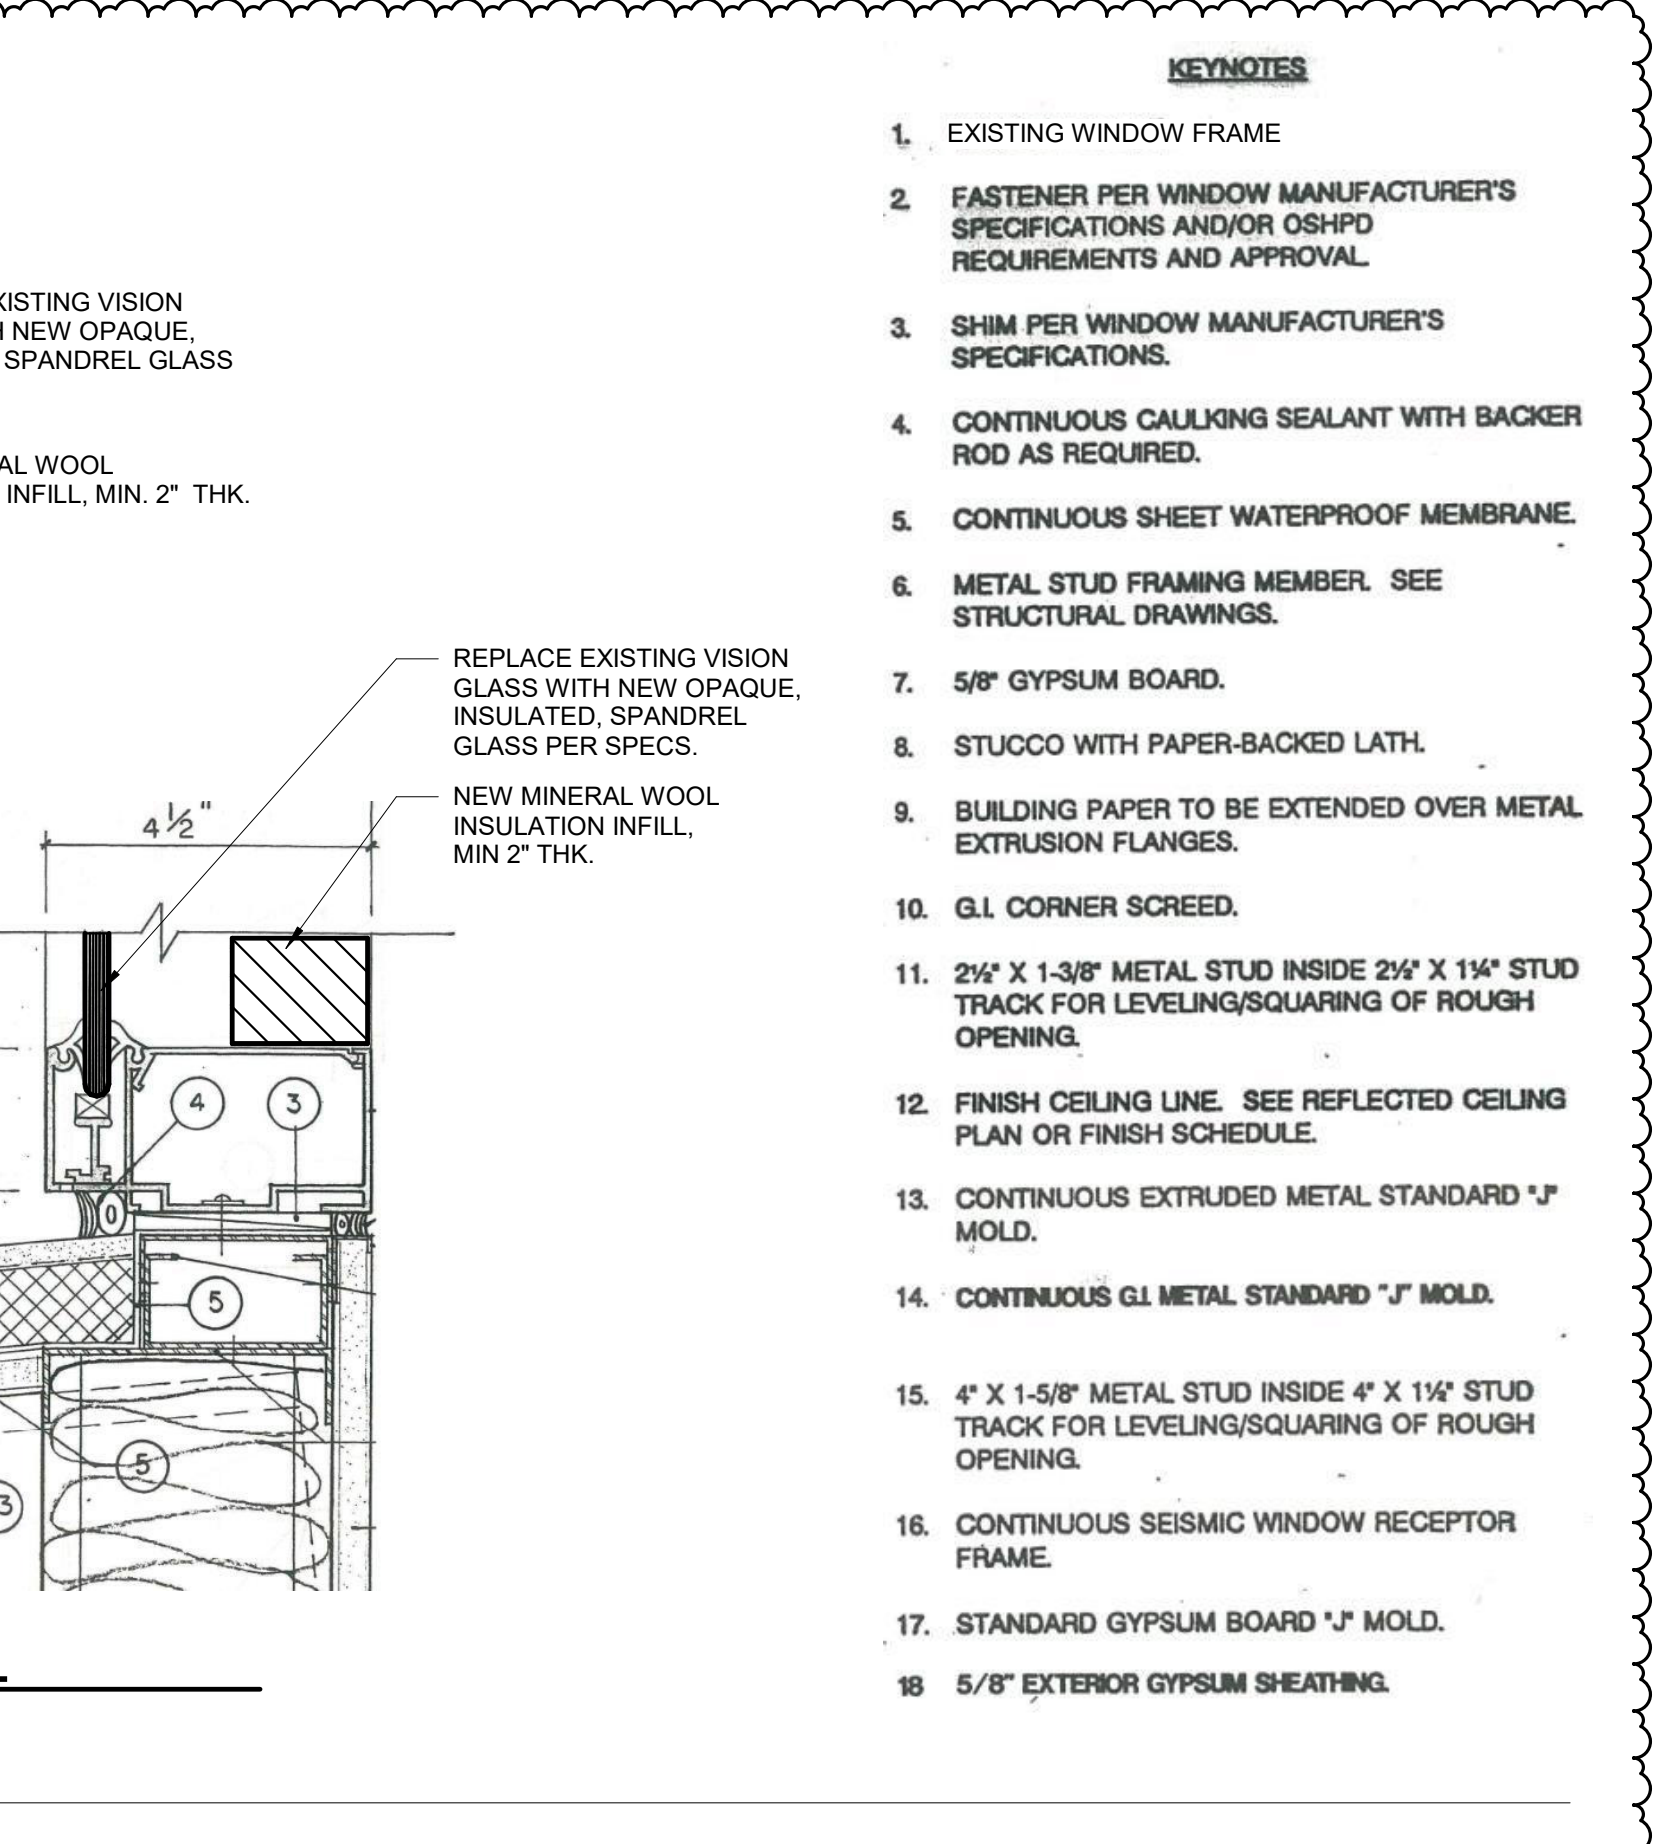

## C7 2-HR RATED ASSEMBLY - HEAD AND SILL

SCALE: 3" = 1'-0"

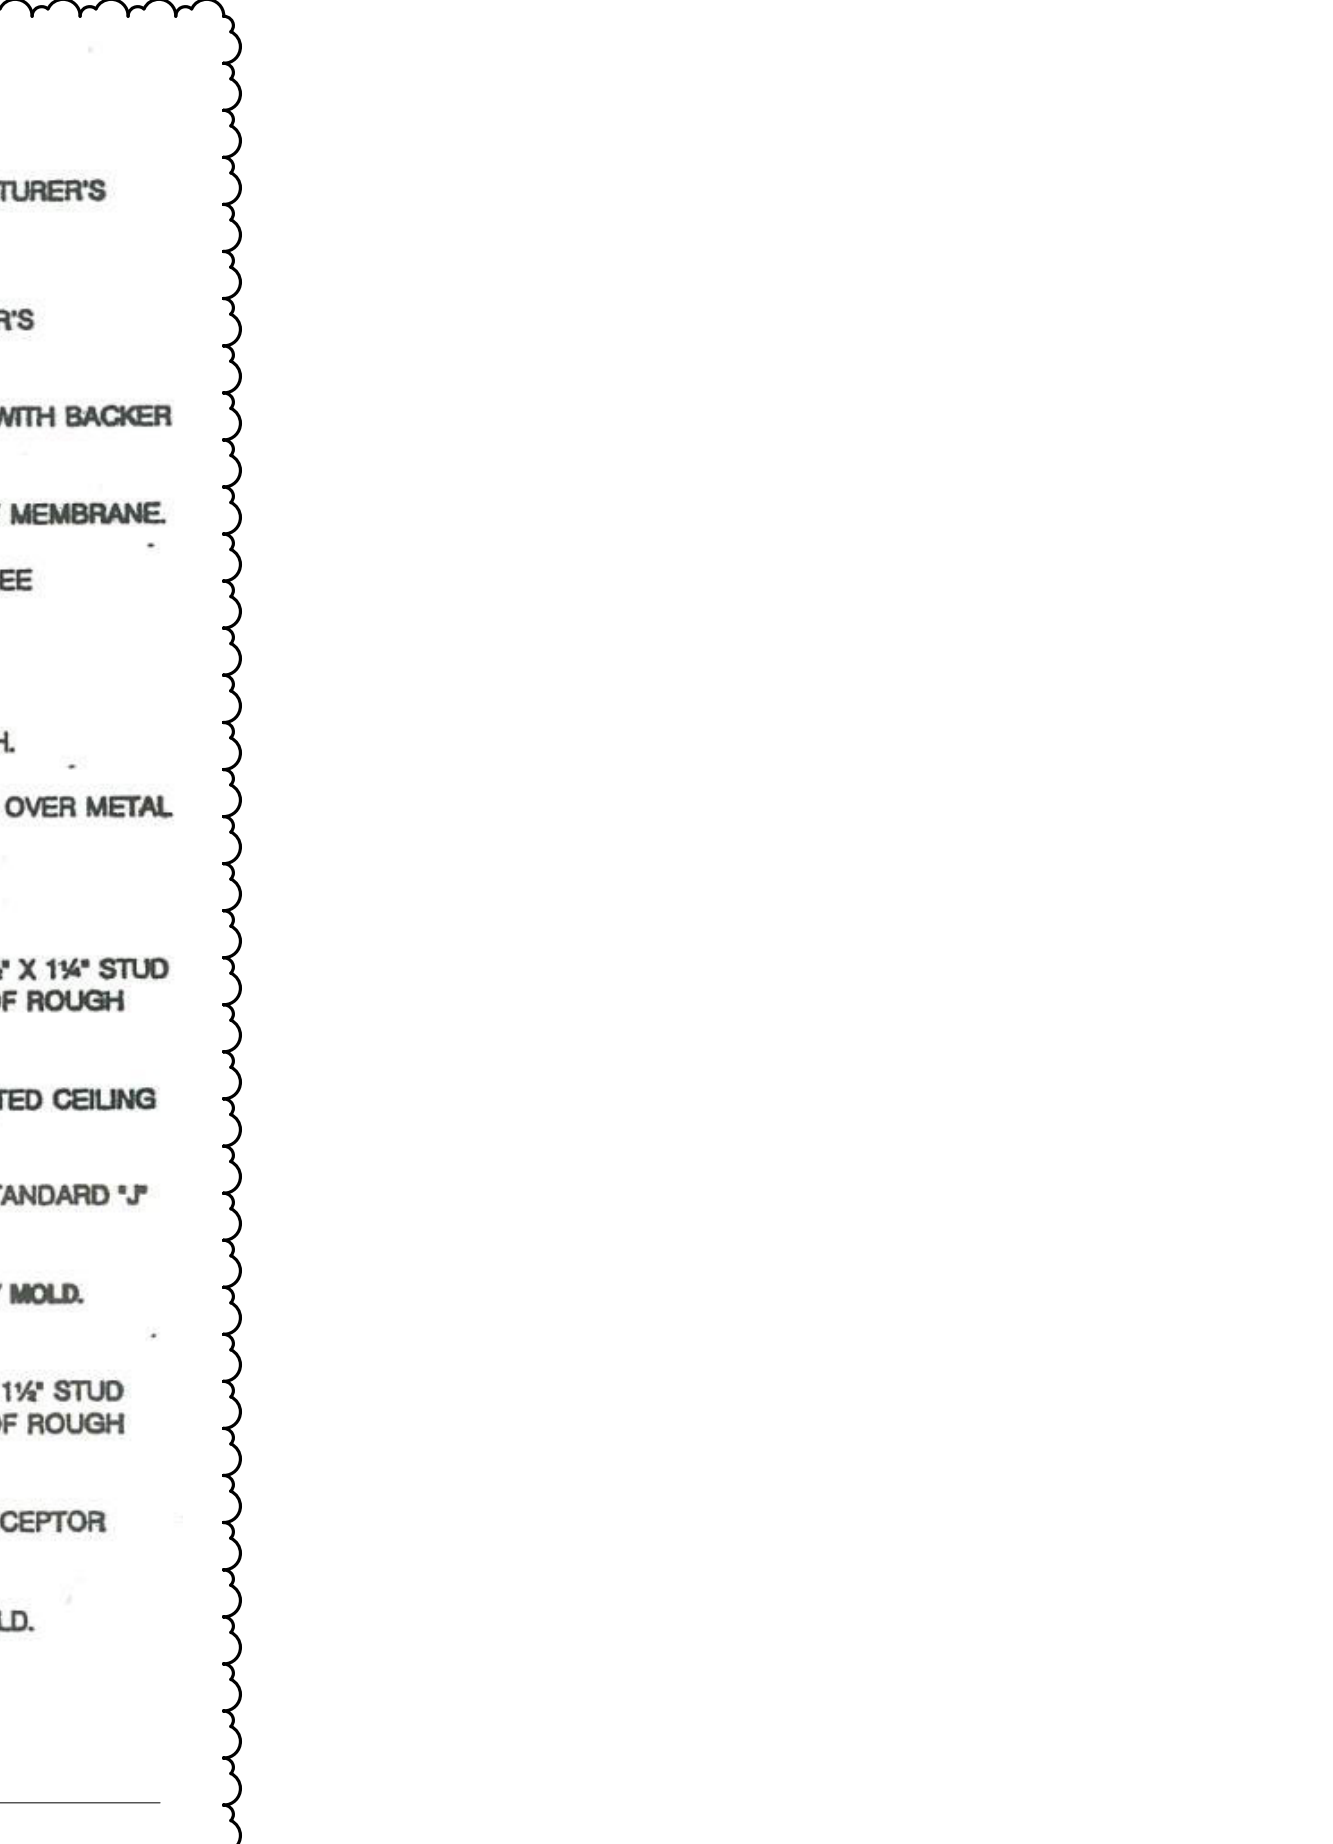

# RIVERSIDE UNIVERSITY HEALTH SYSTEM

## HEALTH SYSTEM MEDICAL CENTER

26520 CACTUS AVENUE, MORENO VALLEY, CALIFORNIA 92555

# LEO A DALY

550 SOUTH HOPE STREET, SUITE 2700  
LOS ANGELES, CALIFORNIA 90071  
TEL: (213)629-0100 FAX: (213)629-0070

ARCHITECT STAMP

CONSULTANT

CONSULTANT STAMP

KEY PLAN

REVISIONS

FILE LOG

ACTIVITY BY

DESIGN Designer

DRAW Author

CHECK Checker

ISSUE DATE 2023/05/09

AGENCY APPLICATION NUMBER

S231455-33-00

AGENCY APPROVAL STAMP

BUILDING TITLE

RIVERSIDE UNIVERSITY HEALTH SYSTEM MEDICAL CENTER

PROJECT TITLE

NEW CARDIAC CATHETERIZATION LAB SUITE & HYPERBARIC FACILITY EXPANSION

RUMS-MC PROJ. NO.

FM08430011869

CONSULTANT PROJ. NO.

047-10071-002

SHEET NAME


PARTITION TYPES

SHEET NUMBER

AE511



5/8/2023 3:14:07 PM Autodesk Docs\\047-10071-002\_RUHS-TO-1\_Riverside\_County\_Health\_Care\_Lab\_RUHS-2ND-CATH-LAB-ARCH-INT

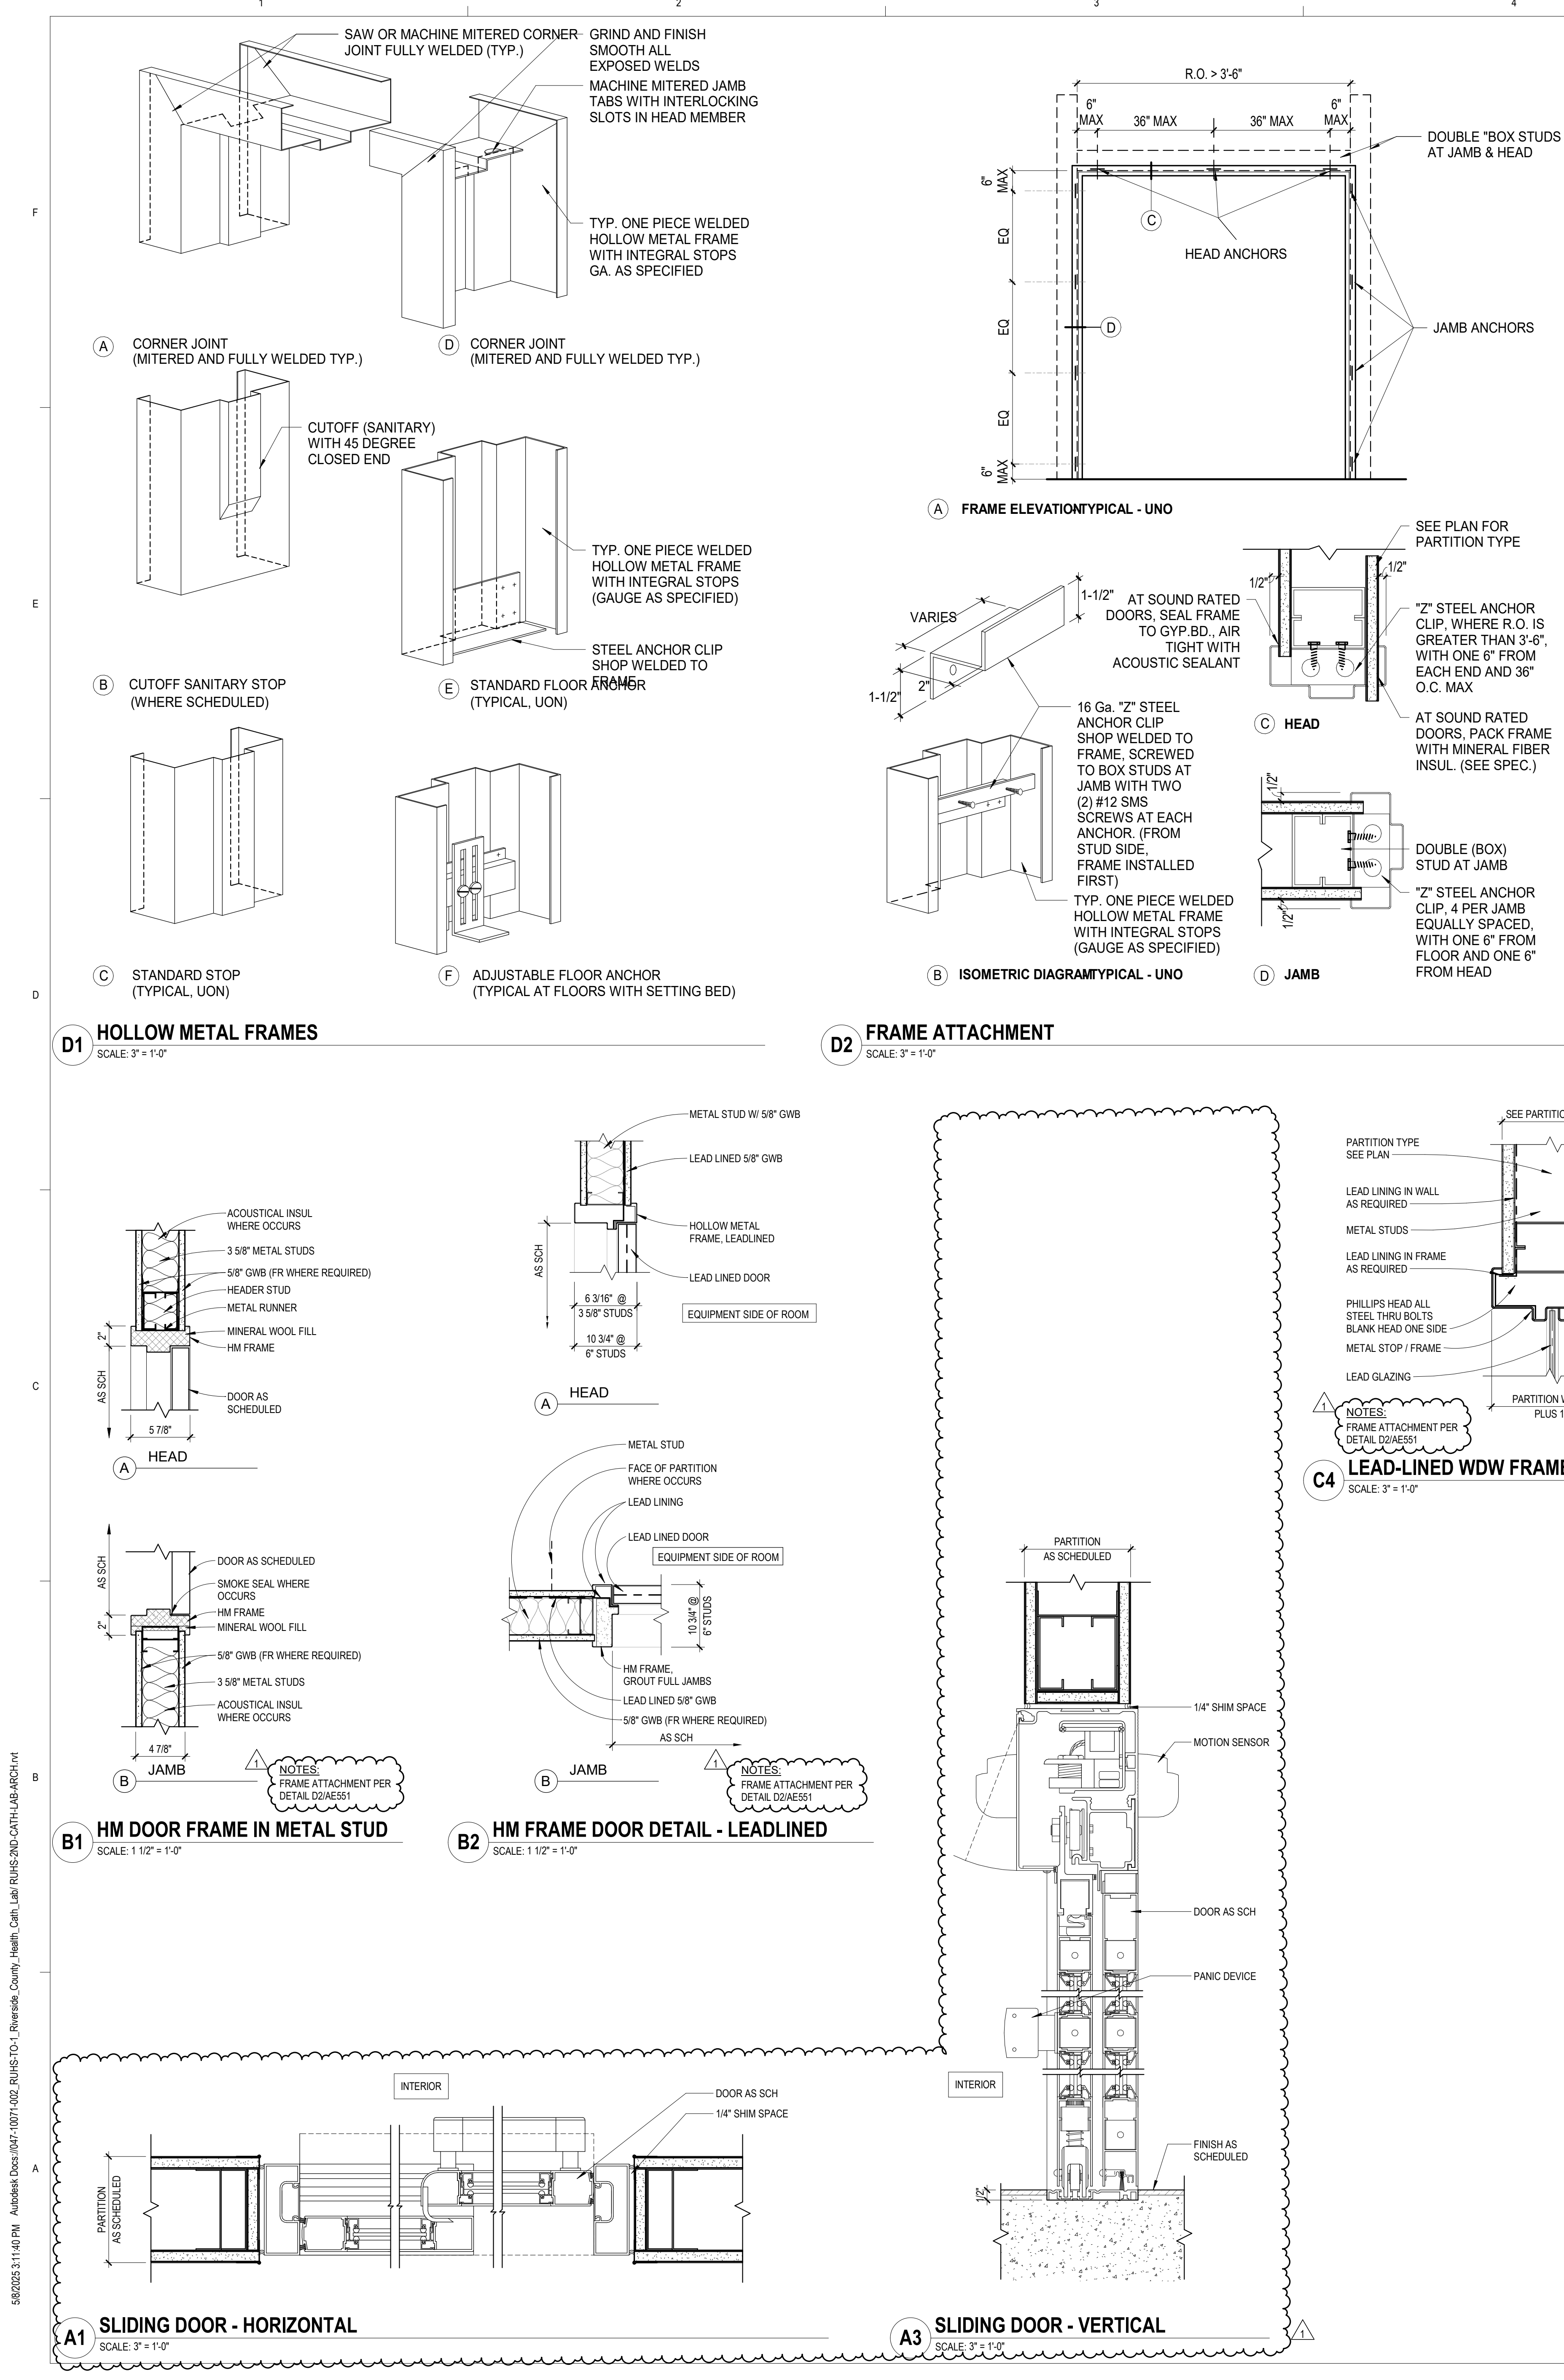

**RIVERSIDE UNIVERSITY HEALTH SYSTEM MEDICAL CENTER**

26520 CACTUS AVENUE, MORENO VALLEY, CALIFORNIA 92555

550 SOUTH HOPE STREET, SUITE 2700  
LOS ANGELES, CALIFORNIA 90071  
TEL: (213)629-0100 FAX: (213)629-0070

ARCHITECT STAMP

CONSULTANT

CONSULTANT STAMP

KEY PLAN

REVISIONS		
NO.	DESCRIPTION	DATE
1	ADDENDUM 01	04/30/2025

FILE LOG

ACTIVITY	BY
Design	Designer
Draw	Author
Check	Checker
Issue Date	2023/05/08

AGENCY APPLICATION NUMBER  
**S231455-33-00**

AGENCY APPROVAL STAMP

BUILDING TITLE  
RIVERSIDE UNIVERSITY HEALTH SYSTEM MEDICAL CENTER

PROJECT TITLE  
NEW CARDIAC CATHETERIZATION LAB SUITE & HYPERBARIC FACILITY EXPANSION

RUHS-MC PROJ. NO. FM08430011869	CONSULTANT PROJ. NO. 047-10071-002
------------------------------------	---------------------------------------


SHEET NAME  
**DETAILS - DOOR AND WINDOW**

SHEET NUMBER  
**AE551**




WINDOW SCHEDULE - NEW WINDOWS									
WINDOW TYPE	Width	Height	FRAME TYPE	FRAME FINISH	DETAIL NO.	DETAIL SHEET	COMMENTS		
W1	12'-0"	4'-0"	HM	PT-	C4	A/E551	LEAD-LINED (L)		
W2	4'-0"	3'-0"	HM	PT-	B5	A/E551	(T)		
W3	4'-0"	4'-2"	EXISTING	EXISTING	A4/AE601	A4/AE601	EXISTING GLAZING AND FRAME TO REMAIN (E)		
W4	3'-0"	4'-0"	EXISTING	EXISTING	A4/AE601	A4/AE601	REPLACE EXISTING GLASS PANEL WITH NEW SPANDREL GLASS IN EXISTING FRAME (S)		


A = 1/4" LAMINATED, CLEAR GLASS  
E = EXISTING GLAZING TO REMAIN  
F = FIRE RATED GLAZING PER OPENING  
PROTECTION LABEL HOUR RATING IN DOOR SCHEDULE  
L = LEAD LINED (MEET SHIELDING REQUIREMENTS ON AE141)  
T = 1/4" TEMPERED, CLEAR GLASS  
S = SPANDREL (COORDINATE TO MATCH EXISTING HOSPITAL  
GLASS COLOR AND CERAMIC FRIT COLOR, V.I.F.)

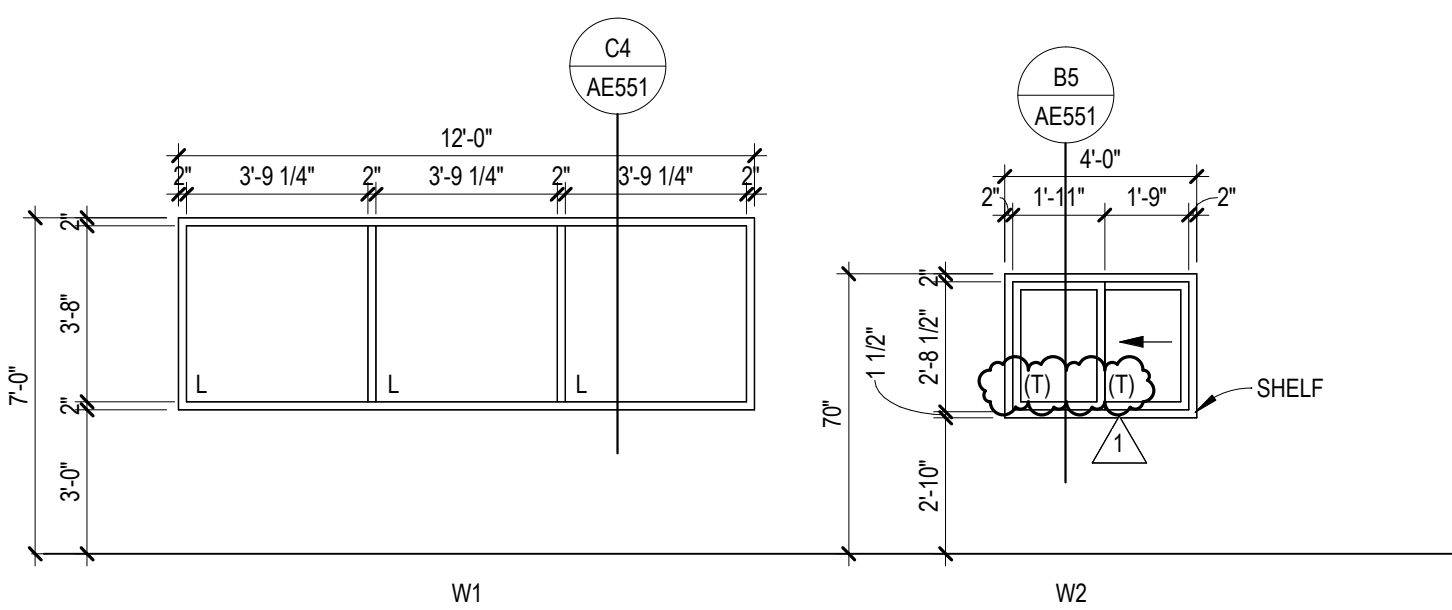


SCALE: 1/4" = 1'-0"

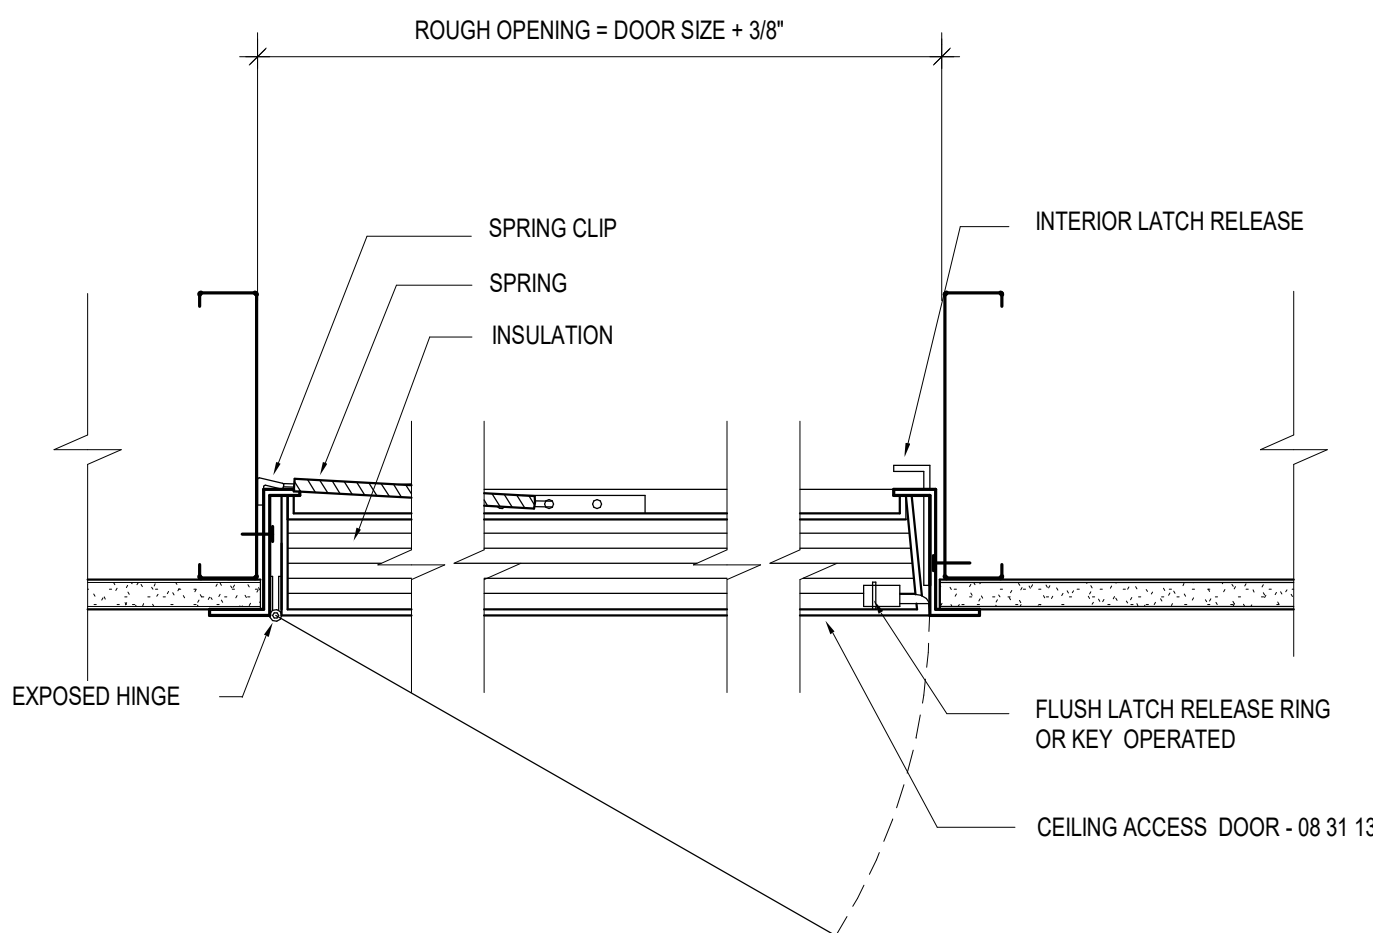

SCALE: 3" = 1'-0"

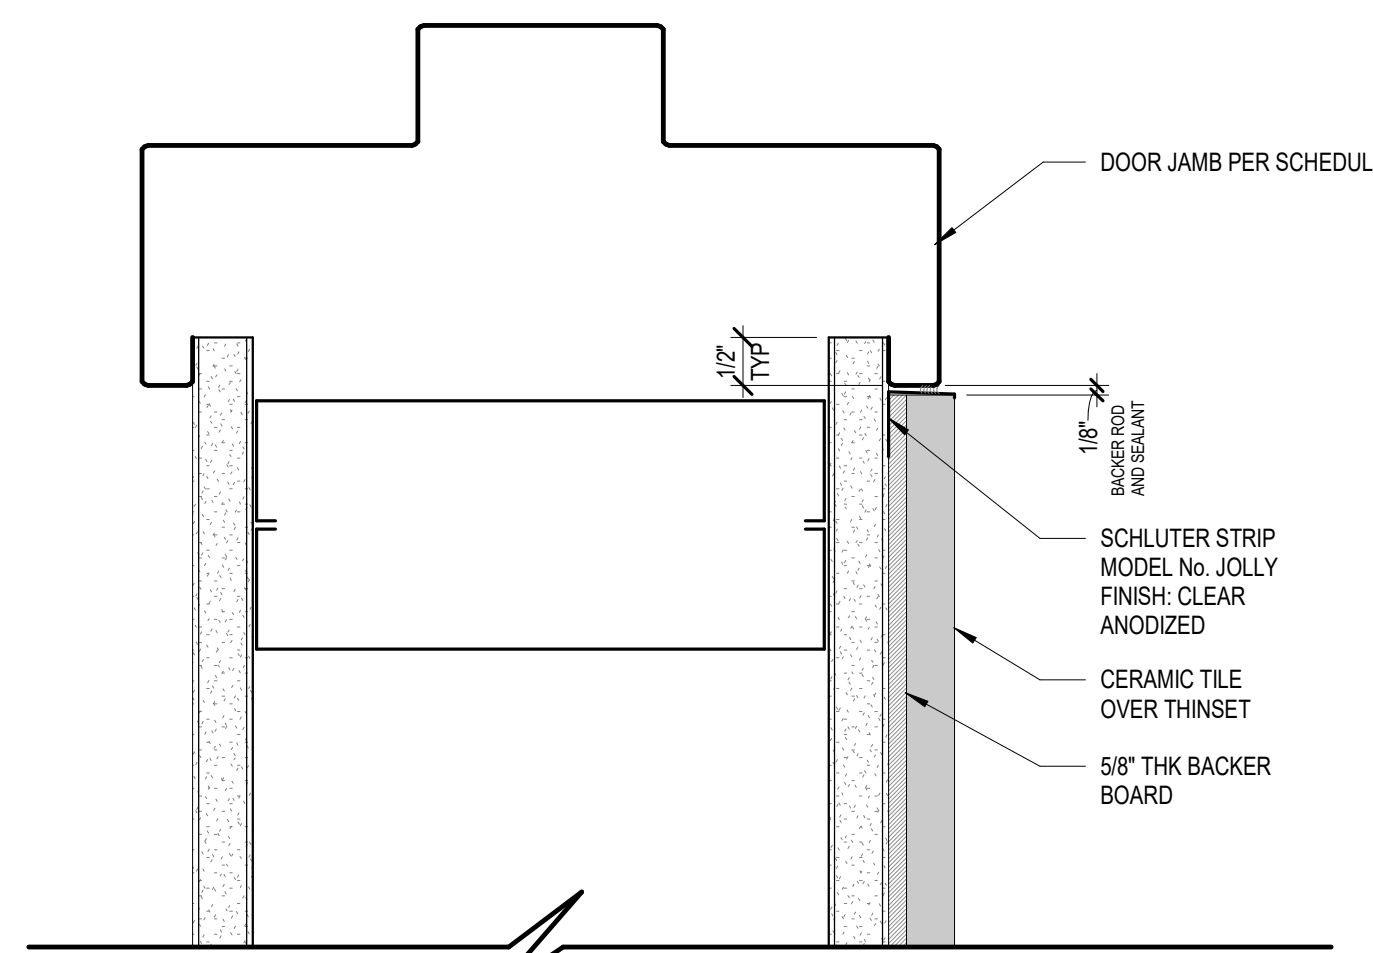


SCALE: 6" = 1'-0"

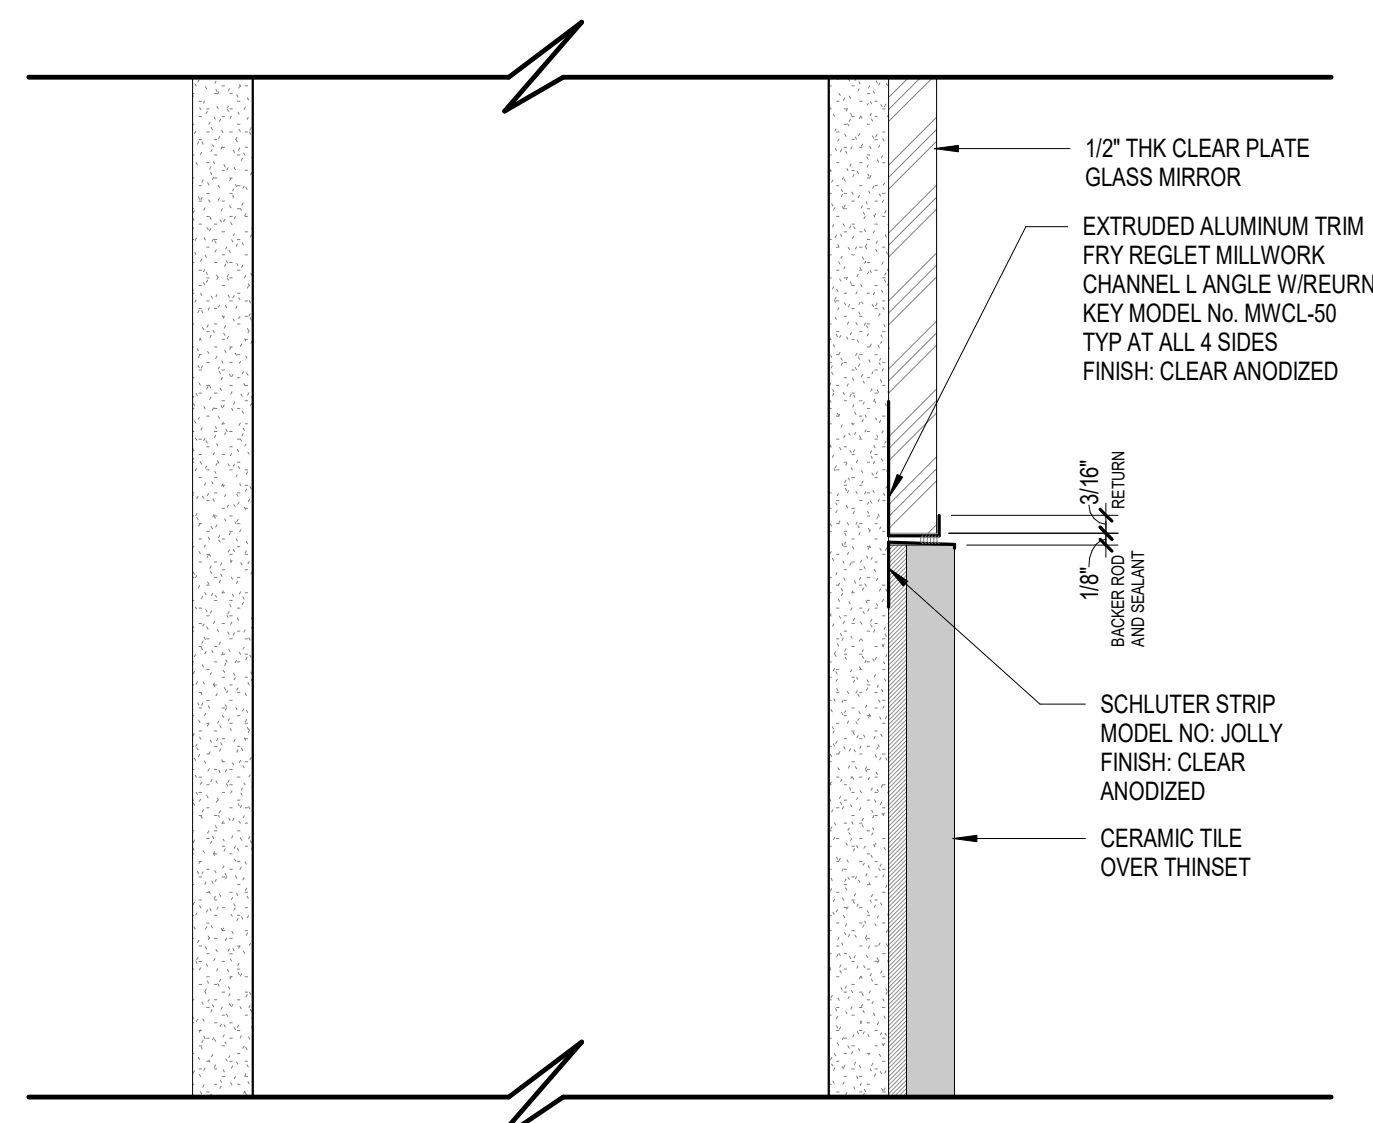


SCALE: 6" = 1'-0"

DOOR SCHEDULE															
DOOR NO.	DOOR TYPE	Width	DOOR HEIGHT	HOWE SET	TYPE	DOOR MATL.	FIN.	TYPE	MATL.	FIN.	FRAME	GLASS	SET SHIT	LABEL HOUR	REMARKS
1032		3'-6"	7'-0"	119	F	WD	P-1	1	HM	P-2	B1		AE551	45	SMOKE DOOR
1035		3'-6"	7'-0"	119	F	WD	P-1	1	HM	P-2	B1		AE551	45	
1037		3'-6"	7'-0"	120	F	WD	P-1	1	HM	P-2	B1		AE551	45	
1038		3'-0"	7'-0"	119	F	WD	P-1	1	HM	P-2	B1		AE551	20 MIN.	
1039		3'-0"	7'-0"	108	F	WD	P-1	1	HM	P-2	B1		AE551	20 MIN.	
1040A	UN	7'-0"	7'-0"	124	F	WD	P-1	1	HM	P-2	B1		AE551	20 MIN.	NOTE 1, 5
1040B	UN	7'-0"	7'-0"	124	F	WD	P-1	1	HM	P-2	B1		AE551	20 MIN.	NOTE 4; PANIC HARDWARE: EACH DOOR LEAF TO BE 20 MIN. FIRE RATED; UNEVEN PAIR DOOR, ONE LEAF 44" CLR WIDTH; PANIC HDWR. HOLD OPENS; OPPOSIT SWING
1040C		3'-6"	7'-0"	112	F	WD	P-1	1	HM	P-2	B1		AE551	45	NOTE 1, 2, 3, 5; PANIC HARDWARE: ONE LEAF 44" MIN CLR WIDTH
1041A		3'-0"	7'-0"	118	F	WD	P-1	1	HM	P-2	B1		AE551	45	
1041B		3'-0"	7'-0"	108	F	WD	P-1	1	HM	P-2	B1		AE551	--	
1041C		2'-2"	7'-0"	122	F	WD	P-1	1	HM	P-2	B1		AE551	--	
1046	UN	8'-0"	7'-0"	101	FFG	HM	P-1	2	HM	P-2	B1		AE551	--	
1047	UN	6'-0"	7'-0"	104	FWD	P-1	1	2	HM	P-2	B2		AE551	20 MIN.	NOTE 1, 2, 3, 5; LEAD-LINED
1047A		3'-6"	7'-0"	116	F	WD	P-1	1	HM	P-2	B2		AE551	45 MIN.	LEAD-LINED
1047A.1		3'-6"	7'-0"	117	F	WD	P-1	1	HM	P-2	B1		AE551	20 MIN.	NOTE 2, 3, 5
1047B		3'-6"	7'-0"	102	F	WD	P-1	1	HM	P-2	B2		AE551	45 MIN.	
1047B.1		3'-0"	7'-0"	116.5	F	WD	P-1	1	HM	P-2	B1		AE551	--	
1049	UN	6'-0"	7'-0"	104	FFW	P-1	1	2	HM	P-2	B2		AE551	20 MIN.	
1049A		3'-6"	7'-0"	116	F	WD	P-1	1	HM	P-2	B2		AE551	45 MIN.	
1049A.1		3'-6"	7'-0"	117	F	WD	P-1	1	HM	P-2	B1		AE551	20 MIN.	LEAD-LINED
1049B		3'-6"	7'-0"	116	F	WD	P-1	1	HM	P-2	B2		AE551	45 MIN.	LEAD-LINED
1051	UN	7'-0"	7'-0"	105	FFW	P-1	1	2	HM	P-2	B1		AE551	20 MIN.	NOTE 1, 2, 3, 5; LEAD-LINED
1051A		3'-0"	7'-0"	114	F	WD	P-1	1	HM	P-2	B1		AE551	--	NOTE 2, 3, 5; EACH DOOR LEAF TO BE 45 MIN FIRE RATED
1051B		3'-0"	7'-0"	115	F	WD	P-1	1	HM	P-2	B1		AE551	--	
1051C		3'-0"	7'-0"	121	F	WD	P-1	1	HM	P-2	B1		AE551	20 MIN.	
1053	PR	7'-0"	7'-0"	103	F	HM	P-1	2	HM	P-2	B1		AE551	45 MIN.	
1054		3'-0"	7'-0"	114	F	WD	P-1	1	HM	P-2	B1		AE551	--	
1055		3'-0"	7'-0"	114	F	WD	P-1	1	HM	P-2	B1		AE551	--	NOTE 1, 4, 5; PANIC HARDWARE
1057		3'-0"	7'-0"	113	F	WD	P-1	1	HM	P-2	B1		AE551	--	
1059A	PR	6'-2"	7'-0"	107	FFG	WD	P-1</								

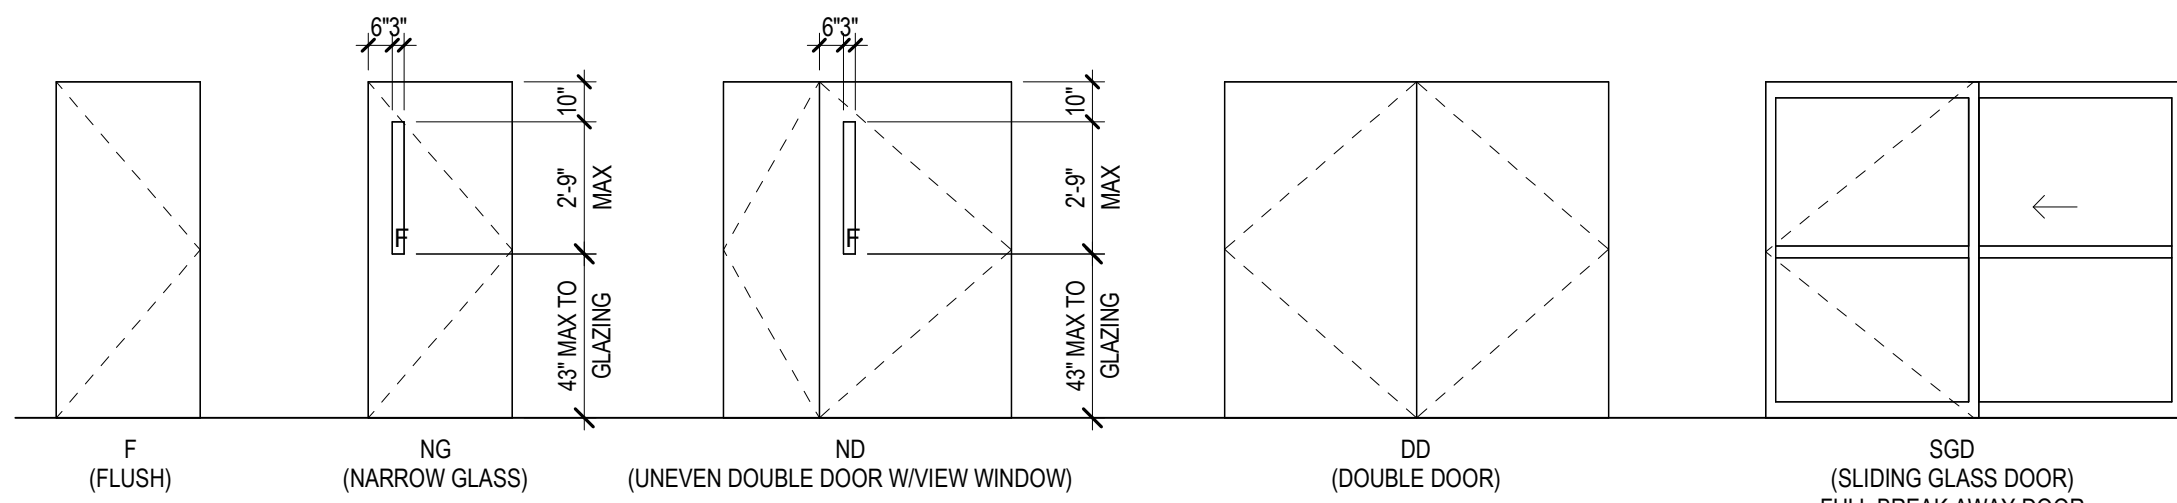


NOTE:  
FOR VISION PANELS IN DOORS ACROSS FIRE BARRIERS  
AND FIRE PARTITIONS, THE FIRE-RESISTANCE-RATED  
GLAZING TESTED TO ASTM E119 IN ACCORDANCE WITH  
SECTION CCBC 716.1.2.3 SHALL BE PERMITTED, IN THE  
MAXIMUM SIZE TESTED

SCALE: 1/4" = 1'-0"

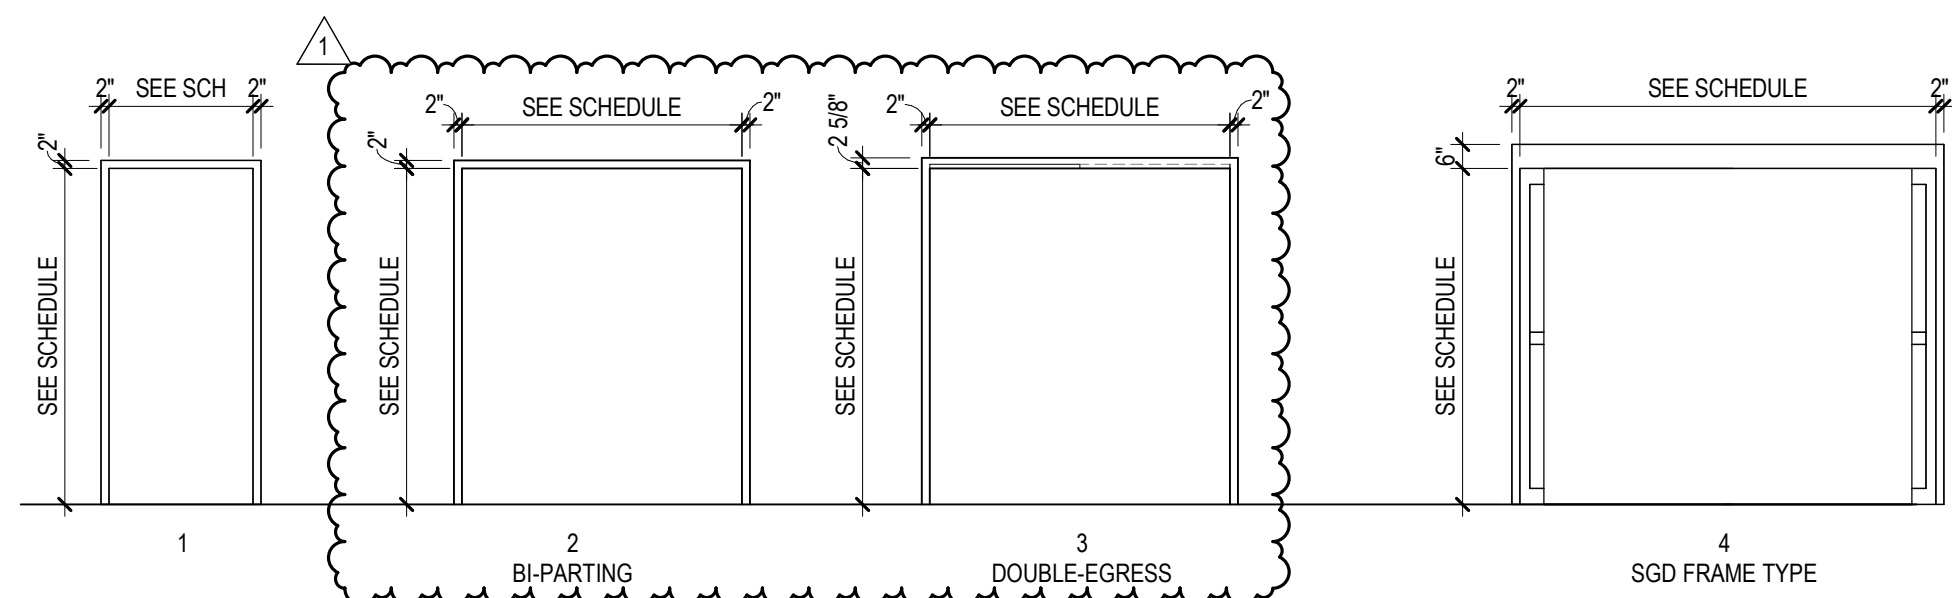

SCALE: 1/4" = 1'-0"

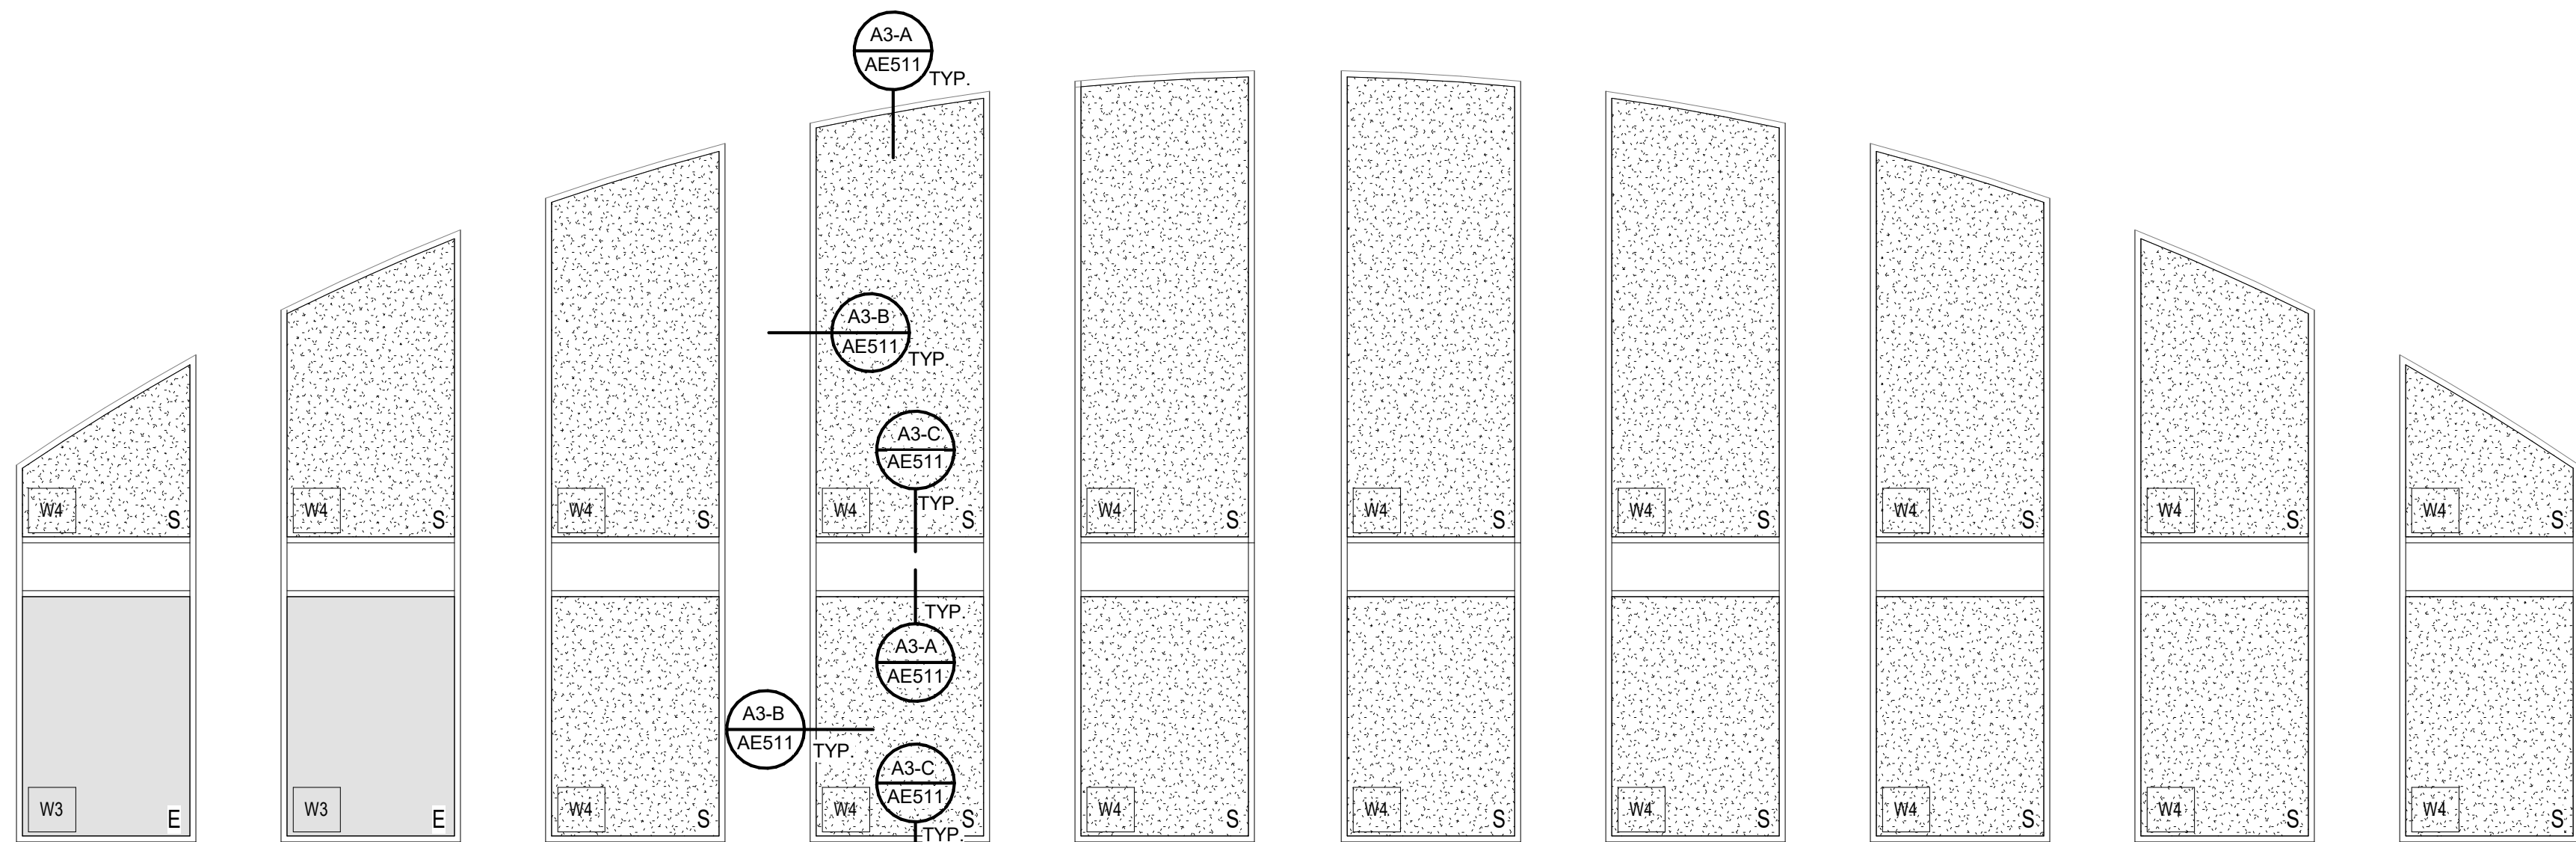

NOTE: SEE WINDOW SCHEDULE FOR GLAZING TYPE

SCALE: 1/4" = 1'-0"

AO	AUTOMATIC OPENER
CR	CARD READER
DA	DELAYED ALARM
EH	ELECTRIC HARDWARE
FAR	FIRE ALARM RELAY
HO	HOLD OPEN
IB	INTEGRAL BLINDS
LD	ER LOCKDOWN
PR	EQUAL PAIR DOOR
UN	UNEQUAL PAIR DOOR

NOTE 1 - HARD-WIRED CARD READER: HARD-WIRED CARD READER LOCATIONS REQUIRE ELECTRICAL AND/OR SECURITY TO COORDINATE. FURNISH & INSTALL COMPONENTS INCLUDING BUT NOT LIMITED TO WIRE, CONDUIT, AND CONNECTIVITY FROM CEILING THROUGH FRAME TO ALL ELECTRIFIED HARDWARE SPECIFIED IN SECTIONS 08 71 00, 08 71 13 AND/OR 08 17 13.


NOTE 2 - AUTOMATIC OPERATOR LOCATIONS: HARDWIRED ELECTRICAL 120V LOCATIONS REQUIRED. ELECTRICAL AND/OR SECURITY TO COORDINATE, FURNISH & INSTALL COMPONENTS INCLUDING BUT NOT LIMITED TO WIRE, CONDUIT, AND CONNECTIVITY FROM CEILING THROUGH FRAME TO COMPLETE ELECTRIFIED HARDWARE SPECIFIED (INCLUDING FOR SWING DOORS 6'X6" BOLLARDS WITH FULL HEIGHT PUSH-PLATE/ACTUATORS AT EACH LEAF INTERIOR AND EXTERIOR) AND AS SEEN IN SECTIONS 08 71 00, 08 71 13, 08 17 13 AND/OR IN DIVISION 08 SLIDING OR REVOLVING DOOR SPECIFICATIONS.

NOTE 3 - AUTOMATIC OPERATOR SURFACE OVERHEAD LOCATIONS REQUIRING 6" OVERHEAD CLEARANCE. SEE SPECIFIED IN SECTIONS 08 17 13.

NOTE 4 (HO) - WALL ELECTRO-MECHANICAL MAG HOLD-OPENS. FURNISH AND INSTALL FIRE ALARM DROP, IN THE EVENT OF FLS(FIRE LIKE SAFETY) OR EMERGENCY OR LOSS OF BUILDING POWER. WALL MOUNTED ELECTRO-MECHANICAL HOLD-OPEN DEVICES TO HAVE POWER DROPPED (DOOR TO SELF-CLOSE AND SELF-LATCH DOORS IN AN EMERGENCY). ELECTRICAL TO FURNISH & INSTALL COMPONENTS INCLUDING BUT NOT LIMITED TO WIRE, CONDUIT, AND CONNECTIVITY.

NOTE 5 - DOORS WHERE ELECTRICAL SYSTEMS THAT MONITOR OR RECORD EGRESS ACTIVITY ARE INCORPORATED, THE LOCKING SYSTEM SHALL COMPLY WITH SECTION 1010.2.11, 1010.2.12, 1010.2.13, 1010.2.14 OR 1010.2.15 OR SHALL BE READILY OPENABLE FROM THE EGRESS SIDE WITHOUT THE USE OF A KEY OR SPECIAL KNOWLEDGE OR EFFORT.

NOTE 6 - PROVIDE SIGNAGE FOR ELECTRICAL ROOM  
LABELED AS "ELECTRICAL ROOM" PER CODE

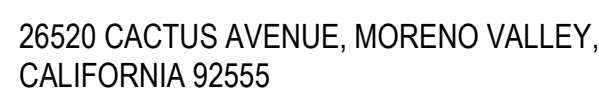

550 SOUTH HOPE STREET, SUITE 2700  
LOS ANGELES, CALIFORNIA 90071  
TEL: (213)629-0100 FAX: (213)629-0070

ARCHITECT STAMP



CONSULTANT

CONSULTANT STAMP

### KEY PLAN

[illegible]

## FILE LOG

ACTIVITY	BY
Design	Designer
Draw	Author
Check	Checker
Issue Date	2023/3/29

AGENCY APPLICATION NUMBER:

**S231455-33-00**

AGENCY APPROVAL STAMP

BUILDING TITLE  
RIVERSIDE UNIVERSITY HEALTH SYSTEM  
MEDICAL CENTER

PROJECT TITLE  
NEW CARDIAC CATHETERIZATION LAB  
SUITE & HYPERBARIC FACILITY EXPANSION

RIHS.MC.PROJ.NO

5100100011000

SHEET NAME

## DOOR SCHEDULE, DOOR TYPES, AND FRAMES

SHEET NUMBER

# AE601



LEO A DALY

ARCHITECT STAMP




CONSULTANT

t: +1.858.597.0555 f: +1.858.597.0565  
5670 Oberlin Drive  
San Diego, CA 92121  
USA

www.exp.com  
Project #: 22013260



CONSULTANT STAMP

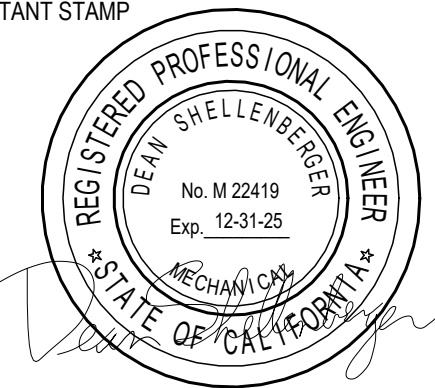

## KEY PLAN

## REVISIONS

[illegible]

FILE LOG

ACTIVITY	BY
Design	Designer
Drawing	Author
Check	Checker
Issue Date	2023/6/12

AGENCY APPLICATION NUMBER:

6231455-33-00

AGENCY APPROVAL STAMP

BUILDING TITLE  
RIVERSIDE UNIVERSITY HEALTH SYSTEM  
MEDICAL CENTER

PROJECT TITLE  
NEW CARDIAC CATHETERIZATION LAB  
SUITE & HYPERBARIC FACILITY EXPANSION

UHS-MC PROJ. NO.

FM08430011869

MECHANICAL ENLARGED PLAN  
PHASE 1 - LEVEL 1 - NORTH

HEET NUMBER

ME211

Copyright © 2020 John Wiley &amp; Sons, Ltd.

**GENERAL NOTES:**

1 REBALANCE RETURN AIR FLOW EACH TIME DEMOLITION AND BYPASS DUCTS ARE TOUCHED (MULTIPLE AIR BALANCE) TO ASSURE  
RETURN AIR REGISTERS REMAIN THE SAME AS PRE-TEST VALUES.

## KEY NOTES

- 201 CAP & SEAL DUCT OPENING.  
202 PROVIDE SEISMIC BRACING FOR EXISTING DUCTS LARGER THAN 6 SF CROSS SECTION.  
211 BALANCE EXISTING REGISTERS AS REQUIRED PER WORK SEQUENCE TO MAINTAIN COMPLIANCE WITH HCAI CAN-102.6.  
216 REFER TO ELECTRICAL DRAWINGS FOR TERMINAL LOCATIONS OF 120V POWER FOR CONTROLS (TYP.)  
401 STEAM HOSE AND CONDENSATE LINES  
402 REFER TO PUMPING DRAWINGS FOR MAKE-UP WATER AND DRAIN CONNECTIONS FOR HUMIDIFIER.  
601 REFER TO ARCHITECTURAL DRAWINGS FOR DETAILS OF OFFSET IN RATED WALLS TO MAINTAIN EXISTING DUCT MAIN LOCATION.  
602 REGION SHOWN ON MECHANICAL FLOOR PLANS INDICATE EXTENT AND LOCATION OF DUCT REQUIRING WALL OFFSET.

# OUTSIDE OF NEW WORK BOUNDARY

## OUTSIDE OF NEW WORK BOUNDARY


## OUTSIDE OF NEW WORK BOUNDARY

## OUTSIDE OF NEW WORK BOUNDARY




# 1 LEVEL 1 - MECHANICAL PLAN ENLARGED REMODEL PHASE 1 - NORTH

$$1/4" = 1'-0"$$




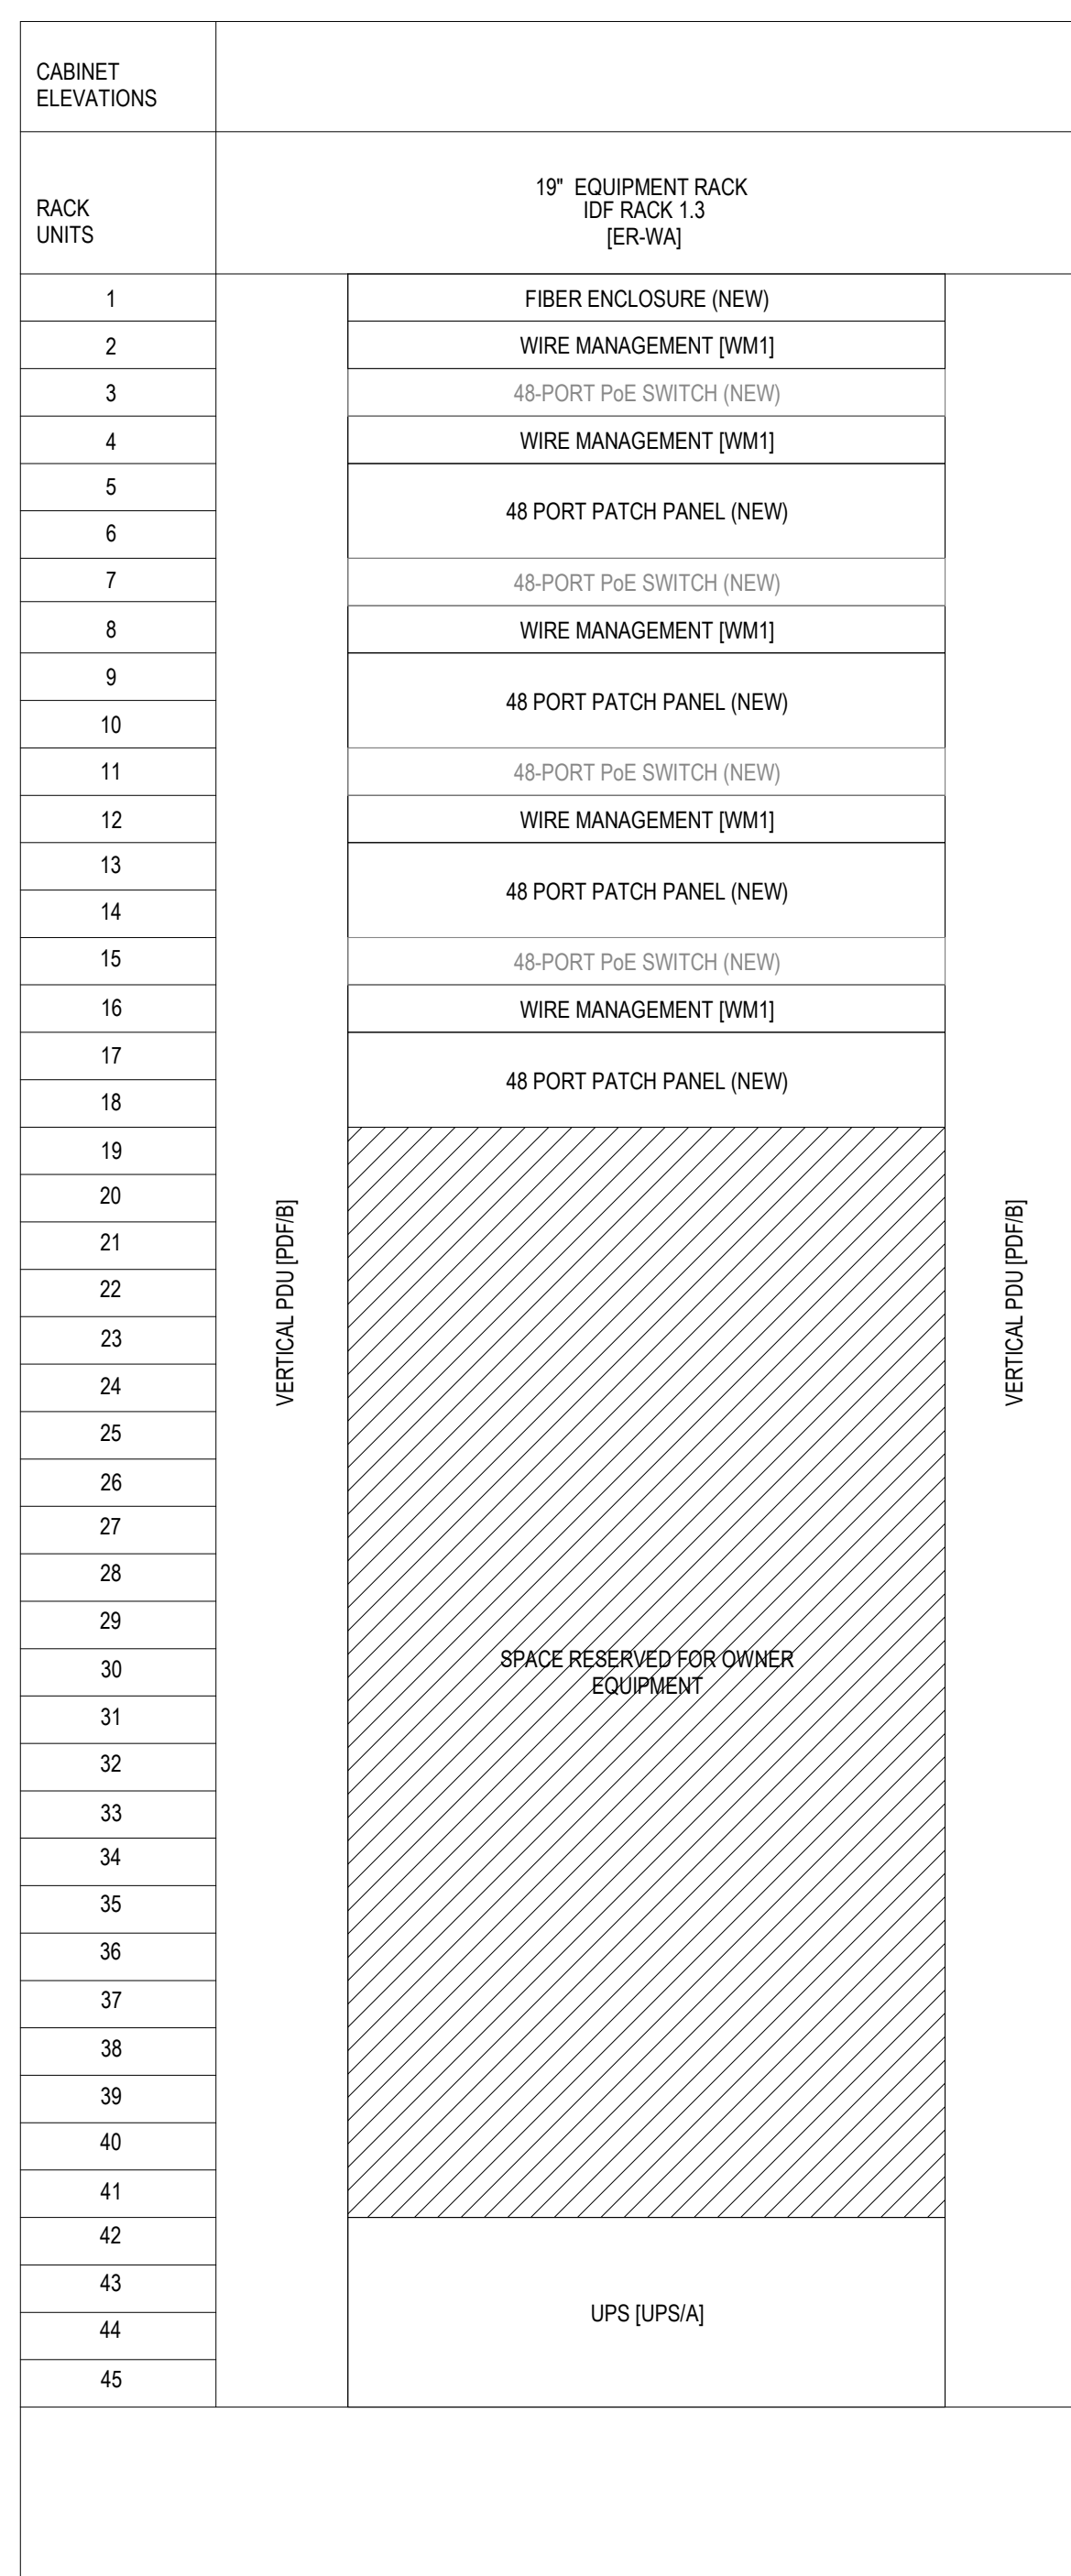

NTS

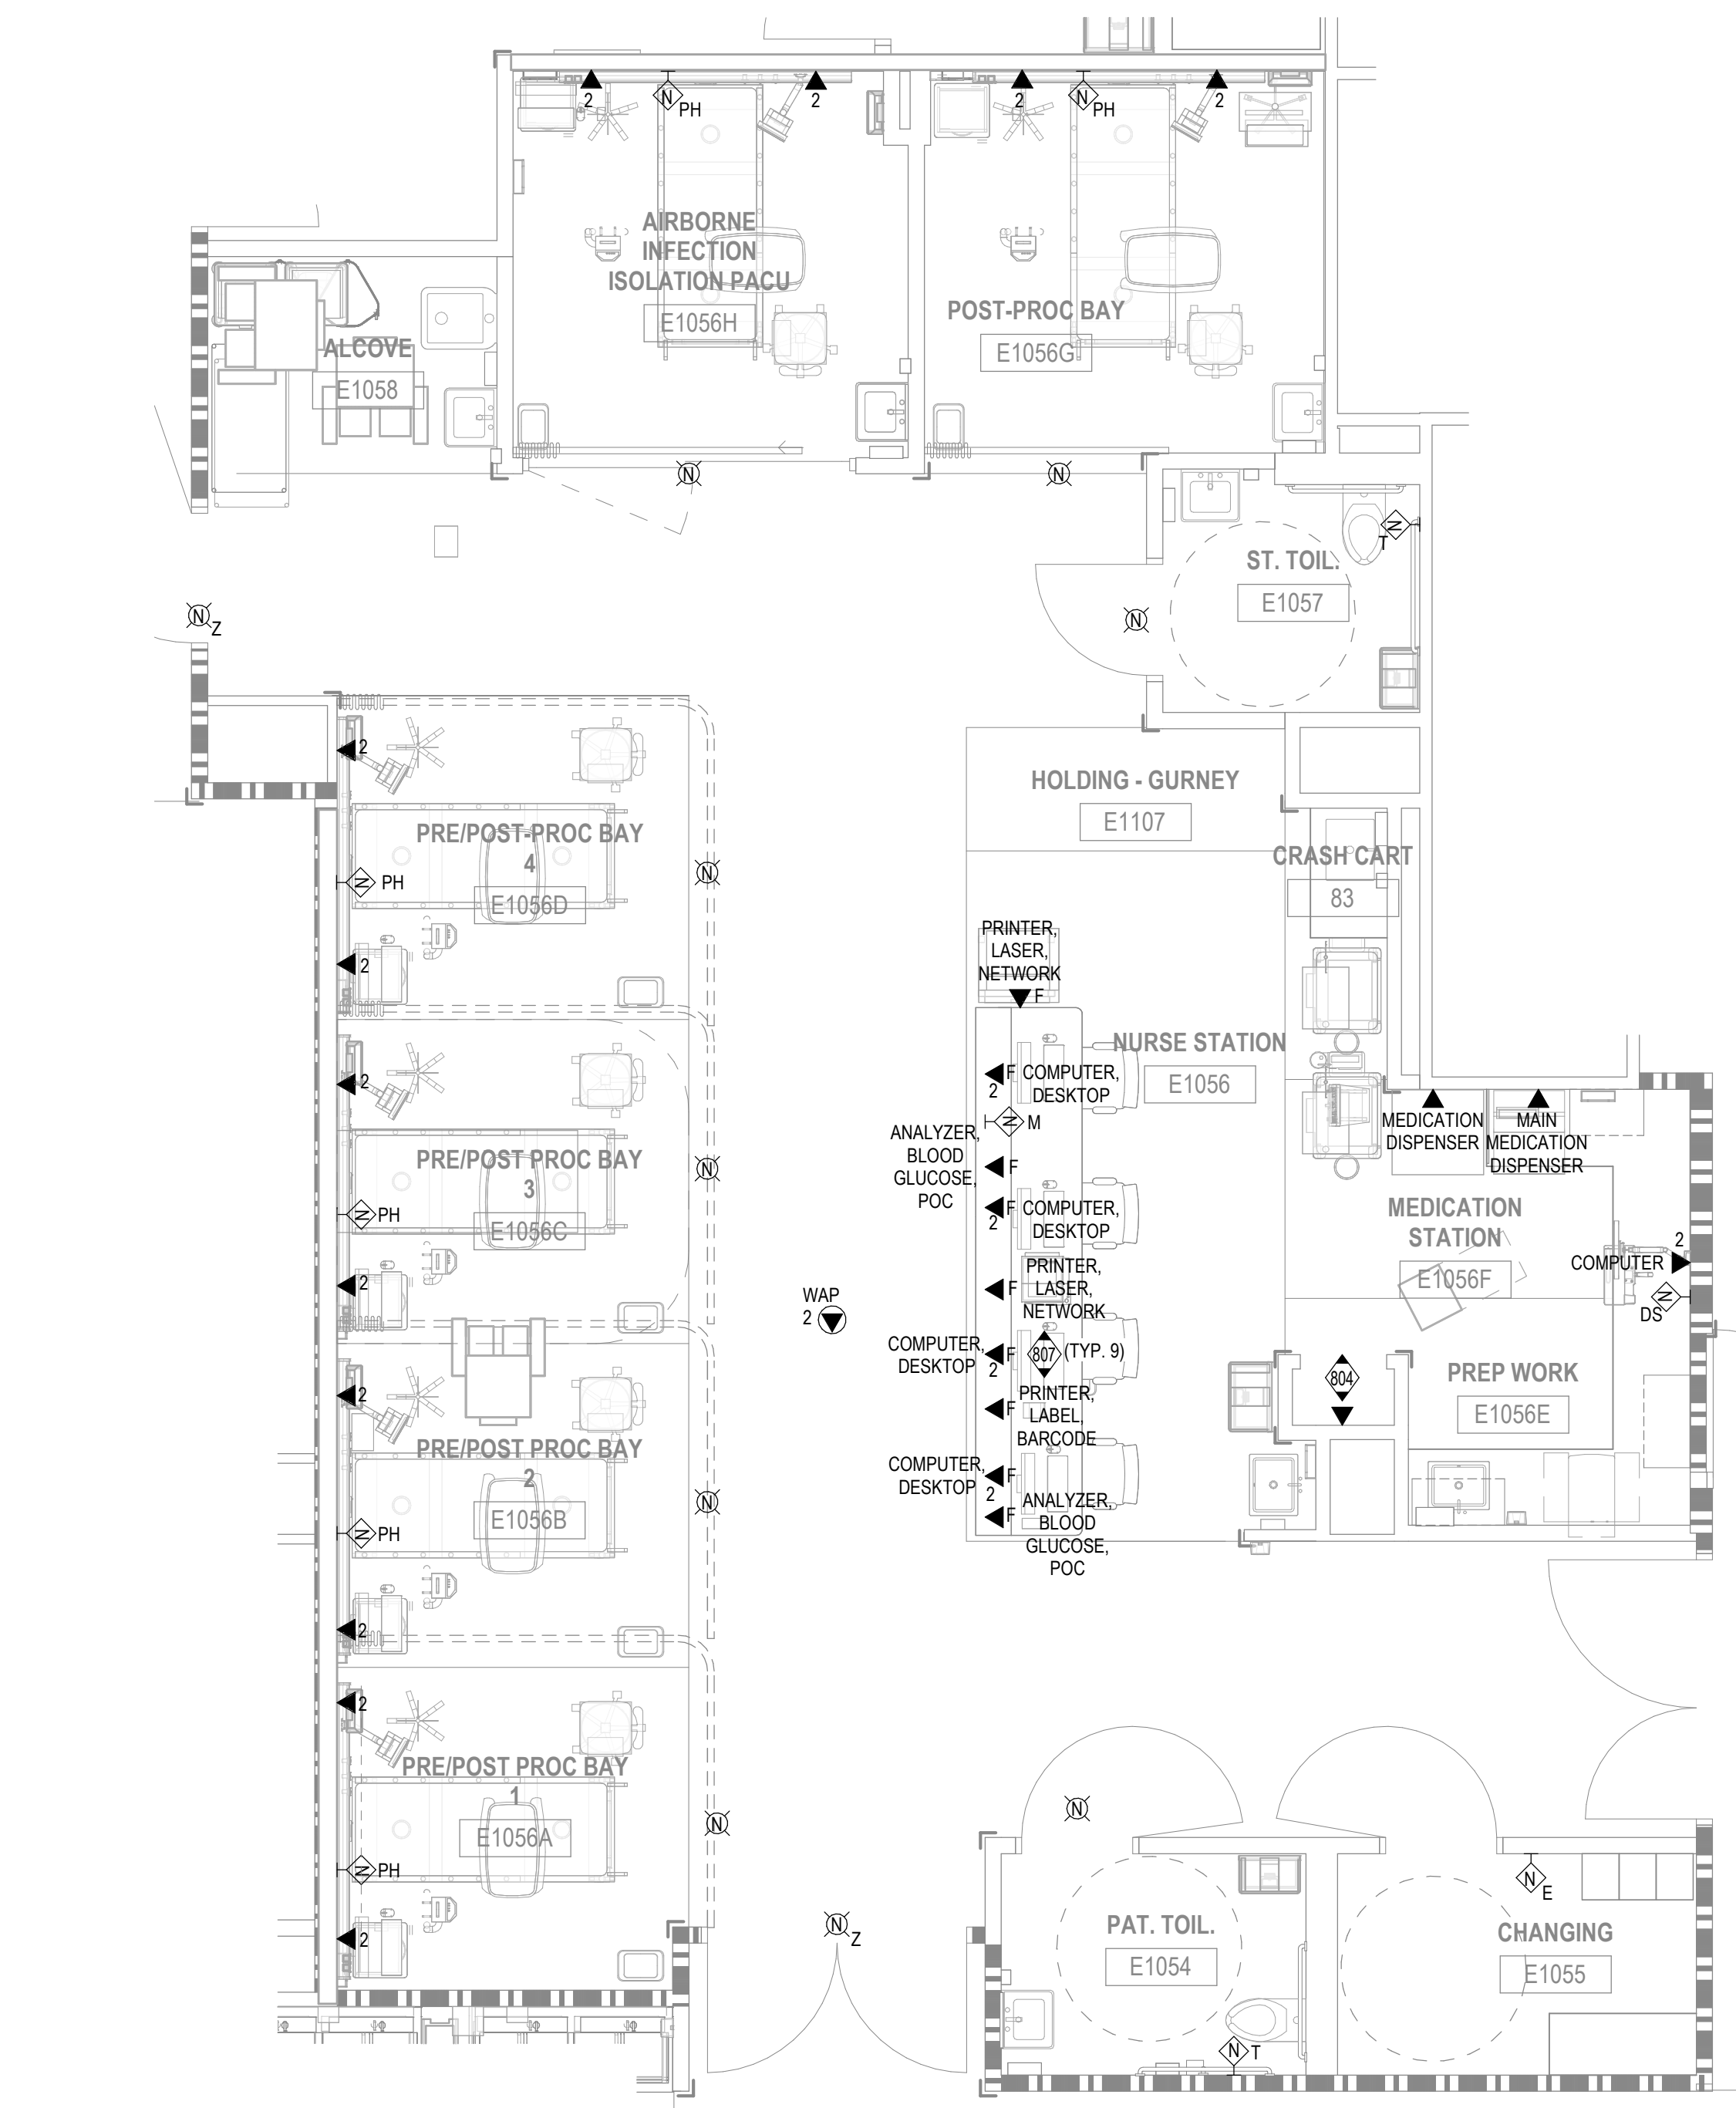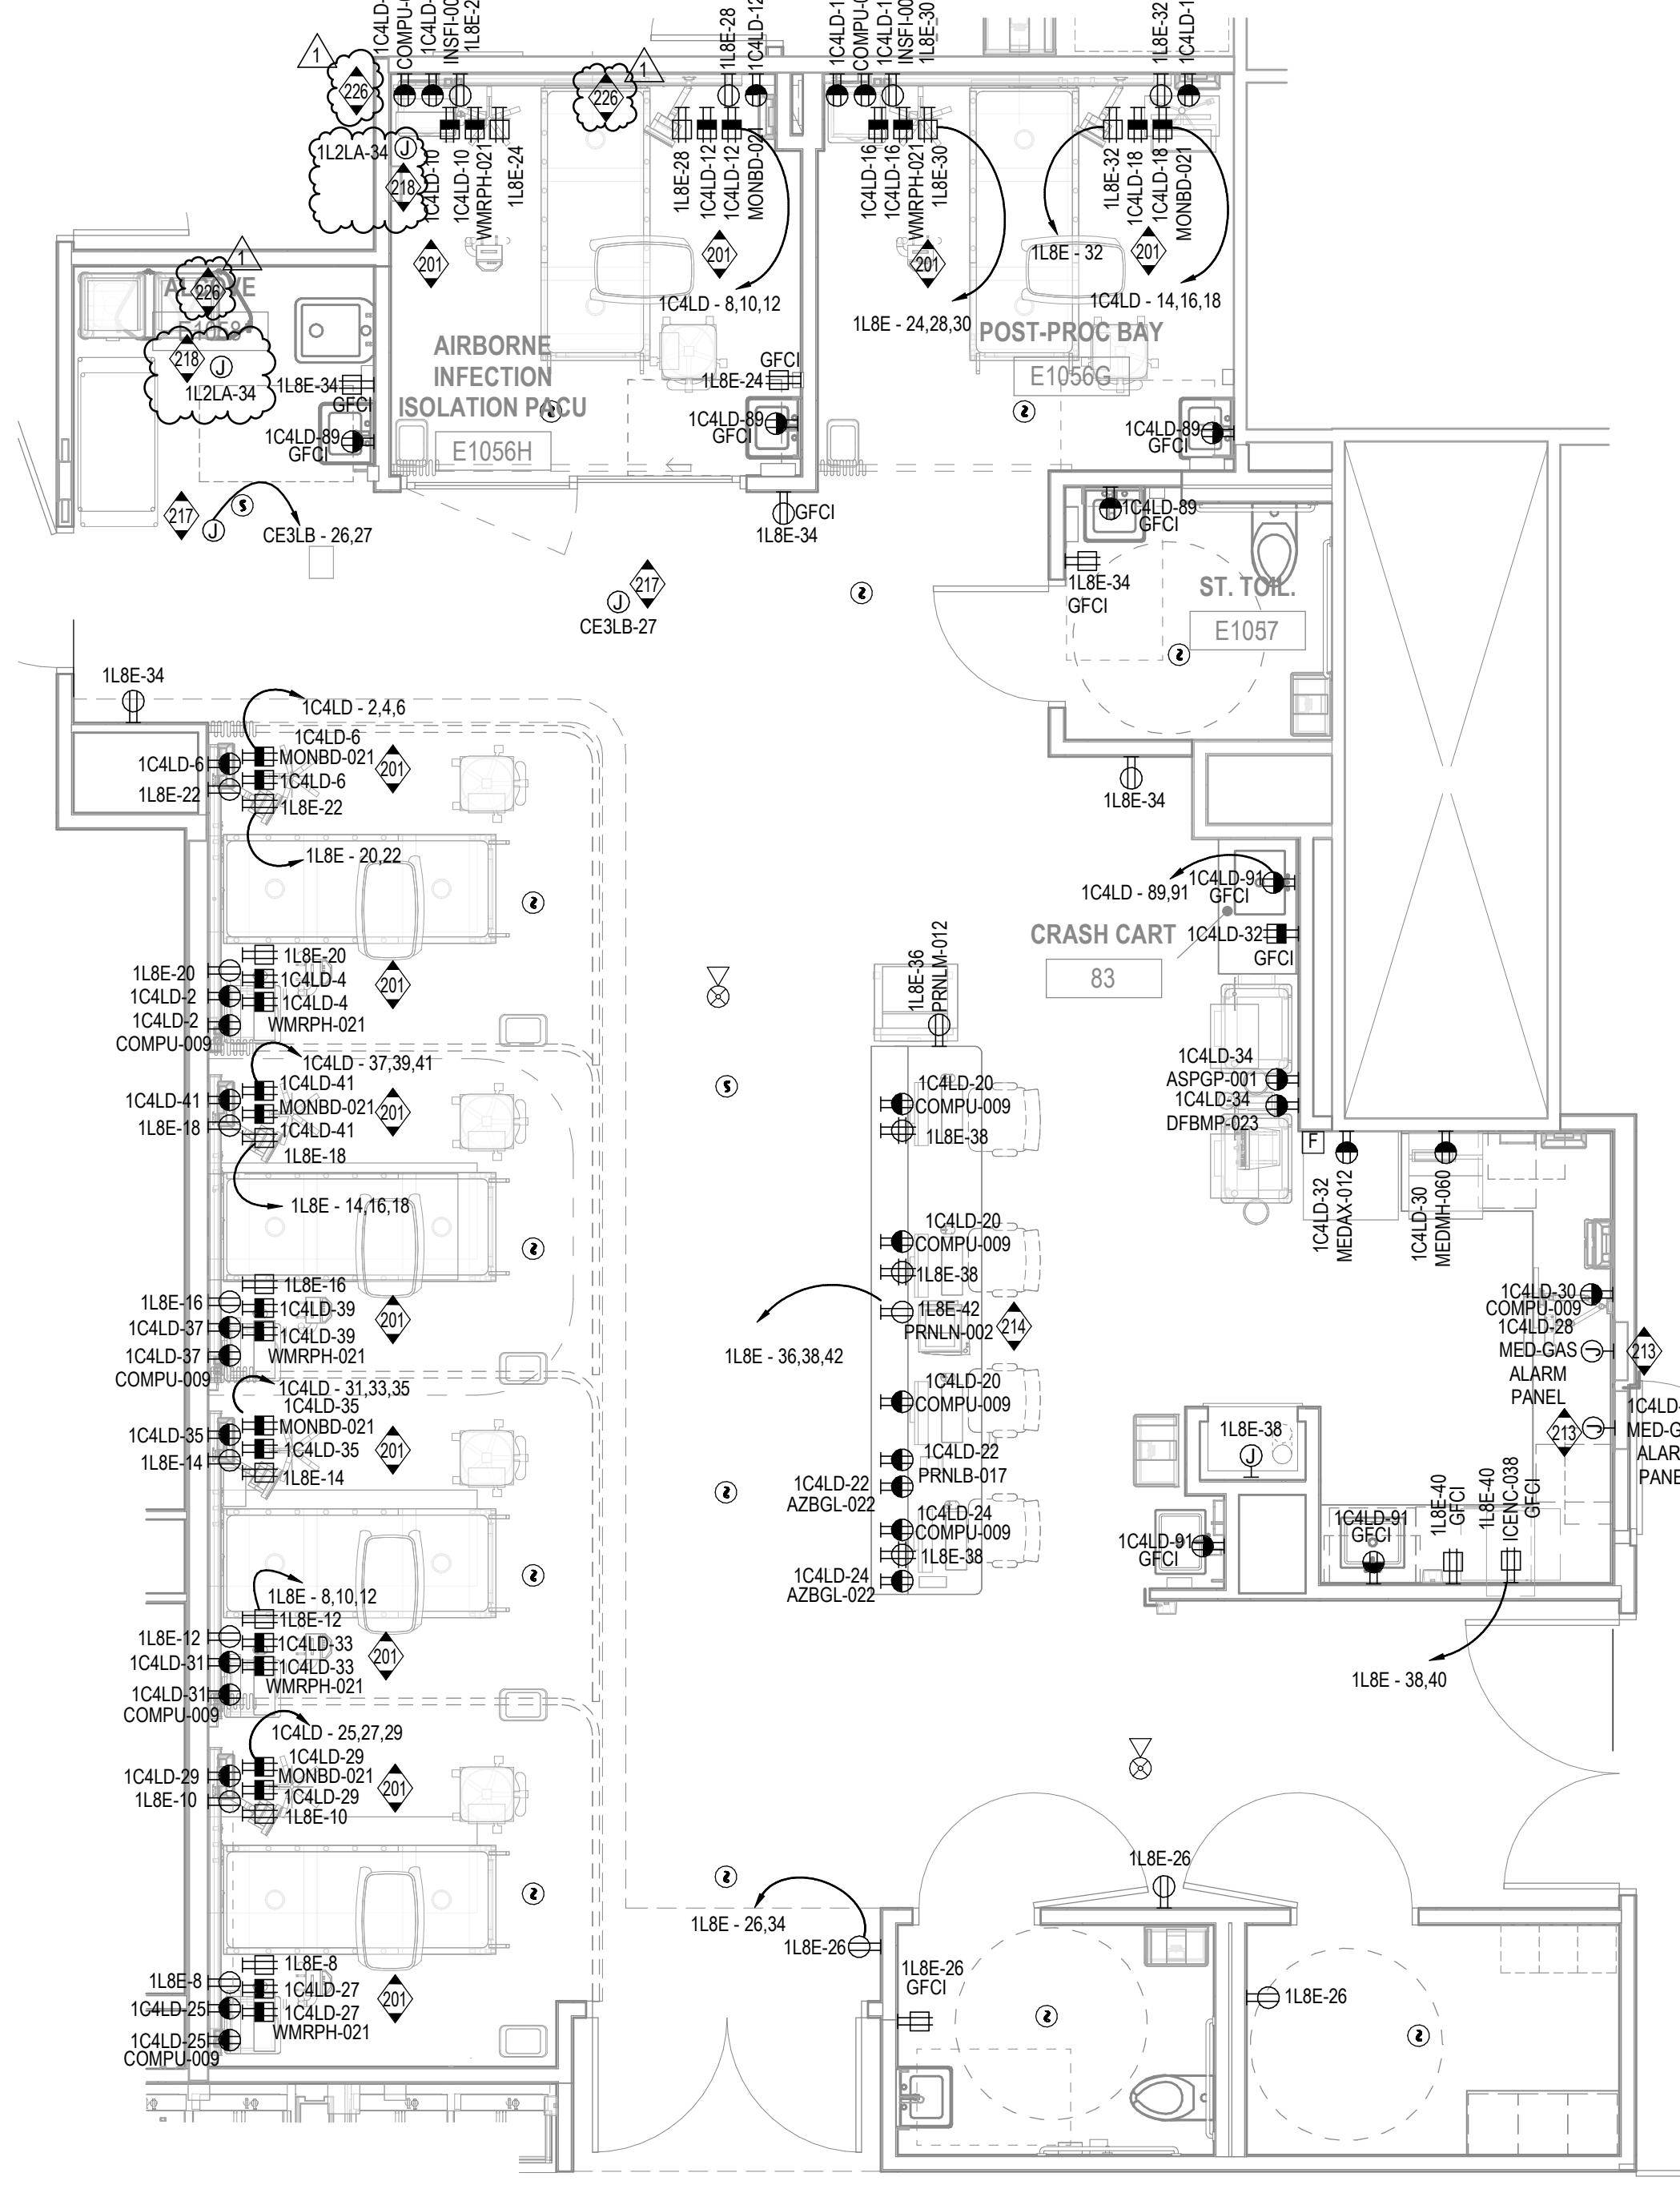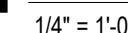 $1/4" = 1'-0"$ 
$$1/4'' = 1'-0''$$
[illegible]

6 DUPLEX RECTANGLES (4 CRITICAL, 2 NORMAL) INSTALLED WITH HEADWIND  
201 REFERENCE TO STRUCTURAL DRAWING DETAILS A1, A504 AND A1, A507 FOR SEISMIC MOUNTING  
202 DETAILS FOR TRANSFORMERS AND PANELBOARDS.  
203 PROVIDE 1X 120V 120/240V 1-PHASE 3-WIRE 1-POLE TERMINATED IN A SURFACE  
204 MOUNTED 450 KVA ATTACHED TO THE TRANSFER RACK USING CIP POWER BOB BRACKET PART  
205 TS100073 (NO KNOWN VALUE).  
206 THE GROUNDING BUSBAR MUST BE CPHI CATHARTHWORTH PRODUCTS PART #1862Z-020 NO  
207 KNOWN VALUE). THE BUSBAR SHALL BE SUPPORTED BY TWO 1/2" DIA. ANCHORS  
208 AT LEAST TWO INCHES OF SEPARATION. BOND THE BUSBAR TO THE BUILDING AC  
209 GROUNDING ELECTRODE SYSTEM. THE MINIMUM SIZE OF THE BONDING CONDUCTOR WILL  
210 BE 4 AWG AND BE SIZED TO CARRY THE MAXIMUM AVAILABLE FAULT CURRENT. THE BUILDING  
211 GROUNDING ELECTRODE CONDUCTOR A SUPPLEMENTAL BONDING CONNECTION  
212 IS REQUIRED TO BE  
213 ORTHOGONALLY WELDED TO THE STRUCTURAL STEEL OF THE BUILDING AND AC SUB  
214 PANEL FEEDING THE ELECTRICAL CIRCUITS IN THIS ROOM. RESISTANCE WILL BE NO MORE  
215 THAN 0.1 OHMS BETWEEN THE TMGB AND THE BUILDING MAIN GROUNDING SOURCE  
216 MEASURED FOLLOWING THE REQUIREMENTS OF THE NATIONAL ELECTRICAL CODE. A GROUND  
217 RESISTANCE TESTER. ALL GROUNDING CONDUCTORS MUST BE RUN IN EMT CONDUIT.  
218 INTERCONNECT TELECOMMUNICATION GROUND BAR AND NEW ELECTRICAL ROOM GROUND BAR  
219 TO BUILDING GROUNDING SYSTEM IN NEAREST ELECTRICAL ROOM. WIRE SHALL BE 30  
220 AWG IN RUN IN EMT CONDUIT.  
221 VERIFY EXISTING LOCATION WITH PLUMBING DRAWINGS PRIOR TO INSTALLATION.  
222 POWER AND DATA FOR NURSING STATION WILL BE SERVED FROM BELOW THRU SINGLE  
223 FLOOR PENETRATION. POWER/DATA CONDUIT WILL BE DISTRIBUTED WITH PONY WALL  
224 COORDINATE WITH ARCHITECT FOR PENETRATION DETAIL.  
225 PROVIDE 120V POWER FOR MECHANICAL CONTROLS. COORDINATE EXISTING LOCATION AND  
226 REQUIREMENTS WITH MECHANICAL DATA PRIOR TO RUN IN.  
227 PROVIDE 120V POWER FOR FIRE SMOKE DAMPERS. REFER TO MECHANICAL DRAWINGS FOR  
228 EXACT LOCATION AND REQUIREMENTS.  
229 WALL SHALL BE 1-HOUR FIRE RATED. ALL PENETRATIONS, FIXTURES AND INSTALLATIONS  
230 WITHIN OR THROUGH WALL SHALL BE FIRE RATED AND COMPLIANT  
231 WITH OSHA DEDICATED FOR 1-PHASE SYSTEM.  
232 THE NEW BRILLIANT RECESSED DOWNLIGHT CABINET SHALL BE CONNECTED TO THE  
233 EXISTING RAILWAY LIGHTING SYSTEM. CABINET LOCATION IN ROOM #1079.  
234 PROVIDE MERAKI CAMERA "MODEL M222X" AND TERMINATE AT THE NEW STRUCTURAL LOCATION  
235 IN THE SAME ROOM.  
236 ROUTE 11-1142 CONDUIT FROM MILLWORK TO THE EXISTING STUBBING ABOVE  
237 ACCESSIBLE PLAFAND. REFER TO DETAIL 9E502.

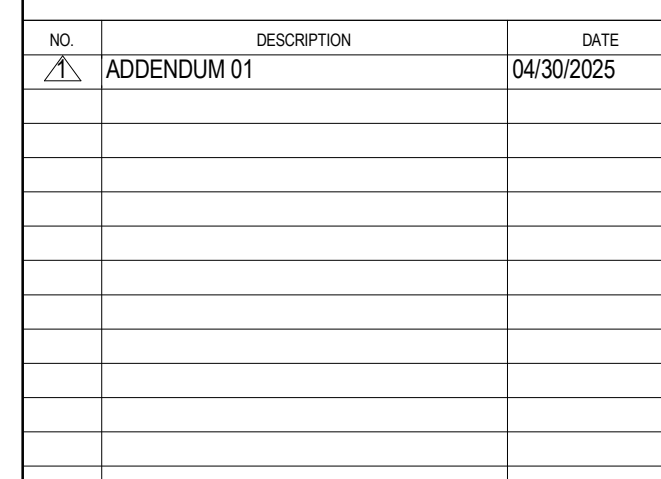

FILE LOG	
ACTIVITY	BY
Design	RY
Drew	Author
Check	PH
Issue Date	2023/8/12
AGENCY APPLICATION NUMBER <b>S231455-33-00</b>	
AGENCY APPROVAL STAMP	

SHEET NUMBER

EE202







[illegible]

</



## SECTION 08 81 10 – INTERIOR GLASS GLAZING

### PART 1 - GENERAL

#### 1.1 SUMMARY

##### A. Section Includes:

1. Tempered glass.
2. Fire-resistant glass ceramic material.
- ~~2.~~3. Ceramic-coated spandrel glass
- ~~3.~~4. Supplementary components and accessories normally furnished or necessary for a complete installation, whether or not such items are indicated on the Drawings or included in the Specifications.

##### B. Related Requirements:

1. Section 08 83 13 for mirrored glass.

#### 1.2 REFERENCES

##### A. Definitions:

1. Manufacturer: Means the primary glass manufacturer, unless otherwise indicated.
2. Fabricator: Means the secondary glass fabricator, unless otherwise indicated.

#### 1.3 ADMINISTRATIVE REQUIREMENTS

##### A. Performance Requirements:

1. Minimum Glass Bite Depth: At least 3/8-inch glass bite depth for 6mm (nominal 1/4-inch) monolithic lites, unless otherwise indicated.
2. Minimum Edge Clearance: At least 1/4-inch for 6mm (nominal 1/4-inch) monolithic lites, unless otherwise indicated
3. Minimum Face Clearance: At least 1/8-inch inch for 6mm (nominal 1/4-inch) monolithic lites, unless otherwise indicated.
4. Safety Glazing Requirements: Provided either fully tempered or laminated glass conforming to ANSI Z97.1 requirements for Drop Height Class A wherever safety glazing is indicated or required. Wire glass is prohibited.
5. Other Requirements: Installed glass must be free from rattle.

#### 1.4 SUBMITTALS

- ##### A. Action Submittals: Submit the following for responsive action (formal review and approval).



1. Product Data: Submit manufacturer's product data, specifications, and all other information necessary to show conformance to the Contract Documents, excluding material safety data sheets (MSDSs) and safety data sheets (SDSs), both of which are returned to the Contractor without review or responsive action.
  2. Glazing Schedule: Submit glazing schedule indicating glazing types, locations, sizes, thicknesses, and extents.
  3. Samples: Submit at least 8-inch square representative samples of each glass type, color, finish, and variety.
- B. Informational Submittals: Submit written descriptions confirming experience specified in QUALITY ASSURANCE article below.

## 1.5 QUALITY ASSURANCE

- A. Source Limitations: Glazing must be obtained through one source from the same manufacturer (to ensure compatibility, regulatory conformance, and a warrantable installation).
1. Certain items may be obtained from more than one manufacturer, but only when used for separate installations.
  2. Items provided for each different installation must be obtained from the same source and manufacturer.
- B. Safety Glazing Certification:
1. Each pane of safety glass delivered to the project site must be furnished with a permanent identification label or mark that identifies the labeler and indicates that safety glazing material is utilized for the installation. Each label must be permanently affixed in a location such that the label remains visible after the pane of glass is installed.
  2. Each pane of tempered glass delivered to the project site must be furnished with a permanent identification label or mark etched or ceramic-fired onto the glass surface that identifies the manufacturer or fabricator and indicates that tempered glass is utilized for the installation. Each label or mark must be permanently affixed in a location such that the label or mark remains visible after the pane of glass is installed.
- C. Qualifications:
1. Manufacturer: Company or individuals must have at least 10 years' experience manufacturing glazing installed on at least 200 previous projects similar to this project in size, material, design, and complexity.
  2. Fabricator: Company or individuals must have at least 10 years' experience fabricating glazing installed on at least 100 previous projects similar to this project in size, material, design, and complexity.
  3. Installer: Company or individuals must have at least 5 years' experience installing glazing for at least 30 previous projects similar to this project in size, material, design, and complexity.



4. Supervisors: Individuals must have at least 7 years' experience installing glazing for at least 30 previous projects similar to this project in size, material, design, and complexity, including at least 2 years' supervisory experience directing and leading glazing installers.

## 1.6 HANDLING

- A. Receiving: Inspect all deliveries for deteriorated, damaged, and defective items.
  1. Reject items that are not packaged in a manner that prevents damage; or that exhibit deterioration or damage or have damaged or open packaging or containers.
  2. Unload and store only inspected and accepted items.
- B. Storage: Store unloaded items as shipped and in conformance with manufacturer's instructions and other requirements and recommendations for storage. Furnish adequate dunnage and bracing during storage.
  1. Prevent stored items from contacting the floor or ground, from soiling and staining, and from deterioration and damage.
  2. If items are not stored in an enclosed location, then cover the tops and sides with securely-tied, waterproof, and breathable covers. Unvented polyethylene tarpaulins do not qualify as breathable covers and are prohibited. (due to potential accumulation of moisture beneath tarpaulin during certain environmental conditions)
  3. Incline covered items to ensure maximum drainage of accumulated moisture.
  4. Do not leave items uncovered where they might be exposed to weather or become wet; or exposed to other sources of deterioration and damage.
- C. Handling: Handle items in conformance with manufacturer's instructions and other requirements and recommendations, and in a manner that that prevents damage.
- D. Damaged Item Replacement: Promptly remove and replace deteriorated, damaged, or defective glass with undamaged new glass that do not exhibit deterioration, damage, or defects.
- E. Packaging Waste Management: Do not burn or bury construction waste at the project site. Remove and legally dispose of all construction waste away from the project site.

## PART 2 - PRODUCTS

### 2.1 PRIMARY GLASS MANUFACTURERS

- A. Manufacturers: Provide products manufactured by one of the following, or equal.
  1. Guardian Industries Corp.
  2. Pilkington North America, Inc.
  3. PPG Industries.



4. Saint-Gobain Corp.

## 2.2 MANUFACTURED GLASS

- A. Ultra-Clear (Low Iron) Annealed Vision Glass:
  1. Description: ASTM C 1036, Type I (transparent flat glass), Class 1 (clear), Quality Q3 (select glazing applications).
  2. Products: Provide one of the following, or equal.
    - a. "Starphire" manufactured by PPG Industries.
    - b. "UltraWhite" manufactured by Guardian Industries Corp.
    - c. "OptiWhite" manufactured by Pilkington North America, Inc.
    - d. "DIAMANT" manufactured by Saint-Gobain Glass.
  3. Performance Requirements:
    - a. Visible Light Transmittance (VLT): At least 90 percent at 6mm thickness.

## 2.3 SECONDARY GLASS FABRICATORS

- A. Fabricators: Provide products fabricated by one of the following, or equal.
  1. Oldcastle BuildingEnvelope Corp.
  2. PPG Industries.
  3. Viracon, Inc.

## 2.4 TEMPERED GLASS

- A. Description: ASTM C 1048, Kind FT (fully tempered), Condition A (uncoated surfaces), fabricated from ultra-clear (low iron) annealed vision glass.
- B. Minimum Surface Compression Strength: At least 10,000 pounds per square inch.
- C. Fabrication:
  1. Fabricate tempered glass by the horizontal (roller hearth) process with roll wave distortion parallel to the bottom glass edge when installed, unless otherwise indicated.
  2. Glazing materials must be free from bubbles, smoke vanes, air holes, scratches and other defects, having ground and arrised edges; provide polished edges where exposed.
- D. Source Quality Control:
  1. Individual tempered glass lites installed overhead, and floor-to-ceiling tempered glass lites installed adjacent to walking surfaces must be fully heat soak tested by the manufacturer or fabricator before delivery to the project site.
  2. Other tempered glass lites may have statistical heat soak testing performed to demonstrate nickel sulfide breakage does not exceed 0.1 percent.



## 2.5 FIRE-RESISTANT GLASS CERAMIC MATERIAL

- A. Description: Clear and wireless fire- and impact safety-rated glass ceramic material conforming to ANSI Z97.1 and CPSC 16CFR1201 (Cat. I and II) with high performance surface-applied fire-rated film.
- B. Products: "FireLite NT" manufactured by Technical Glass Products (TGP), or equal.
- C. Requisite Properties:
  - 1. Fire-Resistance Rating: 20 minutes to 180 minutes with fire hose test.
  - 2. Thickness: 5mm (nominal 3/16-inch).
  - 3. Surface Grade: Premium.
  - 4. Identification: Each fire-rated glazing panel must be labeled with a permanent logo indicating the name of product, manufacture, testing laboratory (UL), fire rating period, safety glazing standards, and date of manufacture.

## 2.6 CERAMIC-COATED SPANDREL GLASS:

- A. Description: ASTM C 1048, Kind HS (heat strengthened) or FT (fully tempered) as indicated, Condition C (spandrel glass, one surface ceramic coated), Type I (transparent flat glass), Class 1 (clear), Quality Q3 (select glazing applications).
- B. Coating: Ceramic enamel coating applied by the silk-screen process.

## ~~2.6~~2.7 ACCESSORIES

- A. Extruded Polystyrene (XPS):
  - 1. Description: Unfaced, rigid, CFC- and HCFC-free, closed cell plastic XPS foam insulation board conforming to ASTM C 578 Type IV physical property requirements, with grooves on one face.
  - 2. Products: "FOAMULAR" manufactured by Owens Corning, or equal.
  - 3. Requisite Properties:
    - a. Minimum Compressive Strength: At least 30 pounds per square inch, when measured in conformance with ASTM D 1621 at either 5 percent deformation or yield, whichever occurs first.
    - b. Minimum Density: At least 25 pounds per square inch, when measured in conformance with ASTM D 1622.
    - c. Minimum Thermal Resistance: Provide material having an R-value of at least R-5 per inch of thickness.
    - d. Minimum Size: At least 8 feet long by 4 feet wide.
    - e. Minimum Thickness: At least 2 inches.
    - f. Edges: Square edges.

- ~~A.~~B. Shoes for Butt Joint Glazing Installations:



1. Description: Brushed stainless steel wide U-channel with top load roll-in glazing gasket for 3/4- glass.
2. Product: "Catalog No. NH3BSCL" manufactured by C.R. Laurence, or equal.
3. Finish: Brushed stainless steel finish.

~~B.C.~~ Shims: Continuous shims fabricated from load-bearing, non-leaching, high-impact polystyrene.

~~G.D.~~ Setting Blocks: Elastomeric silicone rubber conforming to ASTM C 1115, CH9.

~~D.E.~~ Spacers and End Blocks: Provide the following, unless another type, hardness, class, or surface is supplied, required, recommended, authorized, sanctioned, or accepted by the glass installer.

~~E.F.~~ Glazing Gaskets: Fabricate compression gaskets in lengths recommended by gasket manufacturer to fit openings exactly, with allowance for stretch during installation.

1. Firm, Dense Gaskets: Elastomeric silicone or EPDM rubber conforming to ASTM C 1115, CH7S2 unless another type, hardness, class or surface is supplied, required, recommended, approved, or accepted by the glass installer.
2. Soft, Closed Cell Gaskets: ASTM C 509. Provide silicone or EPDM rubber with pre-molded corners.

~~F.G.~~ Cleaners, Primers, Sealers: Supplied, required, recommended, or accepted by the manufacturer or fabricator.

~~G.H.~~ Other Accessories: Provide other accessories and secondary items normally furnished or necessary for a complete installation; or supplied, required, recommended, or accepted by the manufacturer for actual in-service conditions applicable to the project.

## PART 3 - EXECUTION

### 3.1 EXAMINATION

- A. Oversight: Ensure an adequate number of supervisors are present and proper supervision practices are followed at the project site before the installer begins work and at all times during installation.
- B. Verification: Verify in-place construction conforms to the manufacturer's requirements or recommendations and satisfies all other conditions that might affect the quality of installation or the durability, appearance, or performance of installed and adjacent items.
- C. Evaluation and Assessment:
  1. Identify project conditions that do not conform to the manufacturer's instructions and other requirements and recommendations.



2. Perform or arrange and pay costs without reimbursement from Owner for all remedial work necessary to correct or improve deficient conditions, without limitation, before the installer begins work.

### 3.2 INSTALLATION

#### A. General Requirements:

1. Install glazing using materials and methods required, recommended, or accepted by the manufacturer, along with manufacturer-recommended accessories and techniques.
2. Set glazing true to line; plumb, level, and square without warp or rack; with flush, well-fitted joints; and in alignment with adjacent construction.
3. Completed work must match approved samples, as accepted by the Architect.
4. Installed glazing must be warrantable. Do not install, correct, or replace glazing in a manner that is un-warrantable by the manufacturer; or that results in any warranty or guarantee becoming void.

- #### B. Interface with Adjacent Items: Provide materials, components, and accessories normally furnished or necessary to securely attach glazing to supporting construction.

### 3.3 CORRECTION AND REPAIR

- #### A. Non-conforming, damaged, and defective work must be brought into conformance with the Contract Documents. Correct and repair as necessary, without limitation, including arranging all correction and repair work and paying all correction and repair costs without reimbursement from Owner, until accepted in writing by the Architect.

- #### B. Corrective and repair work must be performed in conformance with a correction and repair plan submitted to and accepted in writing by the Architect before correction or repair work begins. At a minimum, correction and repair plans must include

1. written descriptions of non-conforming, damaged, and defective work;
2. supporting sketches, diagrams, photographs, and other visual depictions of non-conforming, damaged, and defective work; and
3. similar written descriptions and visual depictions of Contractor-proposed corrections and repairs.

- #### C. Arrange and pay costs without reimbursement from Owner for removing and replacing work that cannot be corrected or repaired to the Architect's acceptance.

### 3.4 CLEANING

- #### A. Cleaning Work: Clean all visible glazing surfaces in a manner that does not result in any warranty or guarantee becoming void. Clean spills, stains, soiling, overspray, and fallout from adjacent surfaces.



1. Use cleaning materials, equipment, and accessories supplied, and means, methods, techniques, and procedures required, recommended, or accepted by the manufacturer.
  2. Do not use cleaning materials or procedures known to change, or that might change, the appearance of exposed finishes or adjacent surfaces; or cause deterioration or damage to exposed finishes or adjacent surfaces.
  3. Protect adjacent surfaces not being cleaned from staining, deterioration, damage, or other detrimental effects caused by cleaning.
  4. Arrange and pay costs without reimbursement from Owner for removing and replacing work that cannot be cleaned to the Architect's acceptance.
- B. Waste Management: After completing the work of this specification section, leave work areas free from debris, waste, scrap, equipment, tools, and other items.

### 3.5 PROTECTION

- A. Protect installed glazing in place from deterioration and damage until Substantial Completion.
- B. Do not store anything adjacent to or against installed glazing unless it is protected from damage, as accepted in writing by the manufacturer's representative. Do not use installed glazing surfaces as work surfaces.
- C. Remove protection when it's no longer needed and before Substantial Completion.

### END OF SECTION

©AWCWEST 20A01 All rights reserved.